


"OTHER" CORNER MAP

OVERISEL T. 4 N. - R. 14 W.

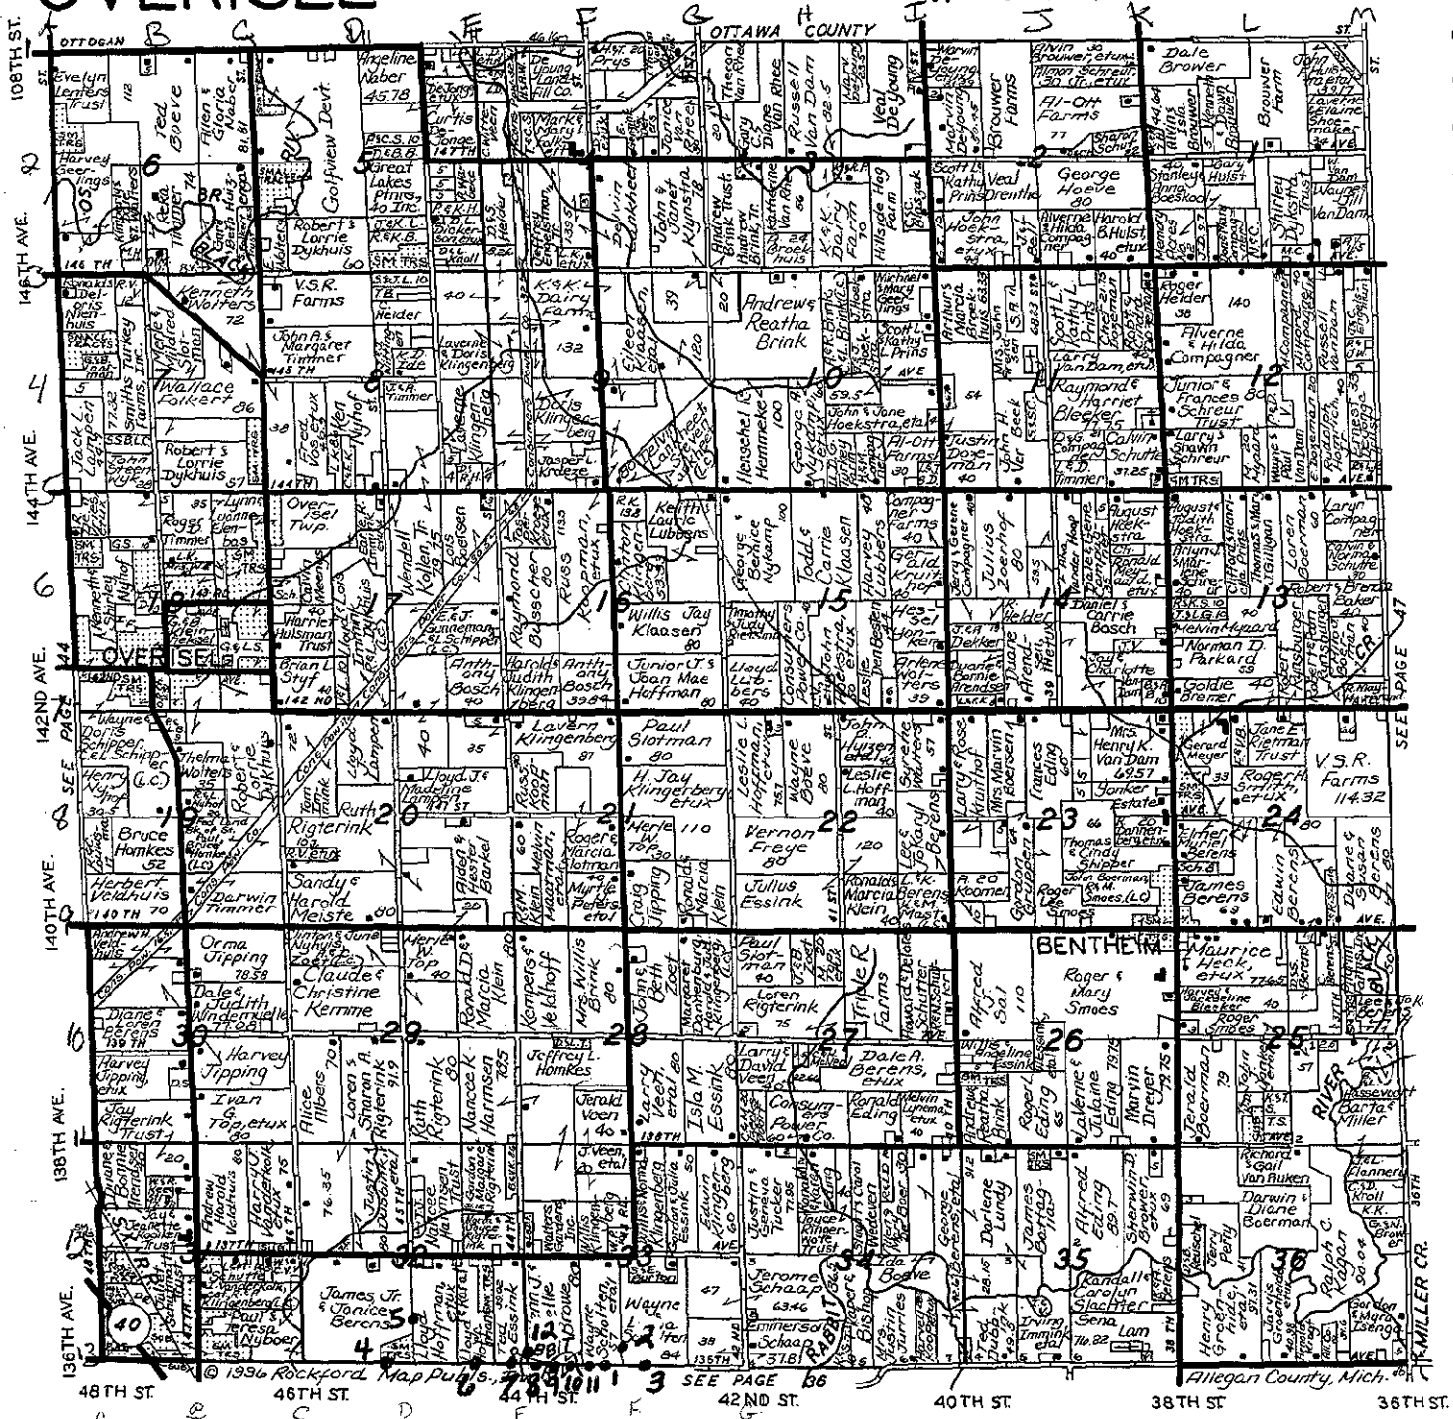

1996 = #1, #2, #3, #4, #5 1997 = #6, #7, #8, #9, #10, #11 1998 = #12

BROEKHUIS BROS. WELL DRILLING

Over 60 Years Experienced Authorized Sales & Service
 WELL DRILLING & REPAIR - 2" TO 10" wells - 5" PVC
 PUMP SALES & SERVICE



STATE LICENSED #0458

CALL HAMILTON
751-2143

A4715 - 142nd Avenue - Holland

KIRK L. VAN ORDER PROFESSIONAL LAND SURVEYOR

3246 Forty-Sixth Street, Hamilton, Michigan 49419

(616) 751-8356

ALLEGAN COUNTY SURVEYOR