

**ALLEGAN COUNTY REMONUMENTATION
LAND CORNER RECORDATION CERTIFICATE**
Filing Requirement of Act 74, Mich. P.A. 1970

FILED

1/28/1999 2:44:39 PM

JOYCE A. WATTS
REGISTER OF DEEDS
ALLEGAN COUNTY, MICH

LIBERO 006 PAGE 370

For corners in <u>Allegan</u> (County)	Located In:	Corner Code #
1. Public Land Survey	T4N R15W	A-2
	T R	
	T R	West 1/4 corner,
	T R	Section 6, Fillmore
2. Property Controlling in Section	S T R	Twp.
	S T R	
3. Miscellaneous Property in Sec.	S T R	
	S T R	
4. Lot No. _____, Recorded Plat _____		
5. Private Claims _____		

Register of Deeds Stamp & File Number

I, Steve Lampen, in a field survey on December 4, 1998, do hereby certify that under requirements of P.A. 74, Michigan P.A. of 1970, the corner points mentioned in lines 1 and 2 above were in conformance with regulations and rules therefore as required in the current manual of survey instructions of the United States Department of the Interior, Bureau of Land Management or by a decree of a Court of Law and/or that the corner points mentioned in lines 3, 4 and 5 above were in conformance with the rules of the Michigan Board of Land Surveyors or by a Decree of a Court of Law; established, re-established, monumented, re-monumented, recovered, found as expressed below:

NOTE: Not more than 4 corners, all in the same town and range, may be recorded on this certificate.

A. Description of original monument and accessories and/or subsequent restoration:

A-2 L.C.R.C. - L1, P 293 - Ratekin-1972
GLO - corner 1 1/4" solid iron
Not set by GLO 24" Maple N 70° W 41.97
25" Maple N 45° W 53.95
Gardner - June 7, 1874 12" soft Maple S 45° E 59.91
Stone Fire hydrant N 30° E 44.25
A-1 North 2523.8
A-3 South 2638

L.C.R.C. - L4, P14-Greer 1987
Found 1/2" pipe in mon. box
SE cor. house found. NW 85.92
Hydrant top centerline NE 44.51
NW cor. house found. SE 96.94
SW cor. garage, brick NE 164.35
3/4" pipe in mon. box S 16.21

L.C.R.C. - L2, P91 - Englert-1973
1" iron bar
NW 25.6 guy pole
SW 40.2 power pole
NE 59.08 24" Maple

L.C.R.C. - L3, P61-Bonnema-1976
Found 3/4" solid rod
Centerline hydrant NE 44.11
SE cor. house foundation NW 85.87
PK in side power pole SE 41.07
3/4" iron for Sec. 1 to W S 16.16

A-2 is shown on Plat of Vogelzang Brothers Subdivision - 1986

B. Description of corner evidence found and/or method applied in restoring or reestablishing corner:

A-2 Found 1/2" pipe in monument box on the East line of Section 1, Town 4 North, Range 16 West
SE corner house foundation NW 85.92 SW corner garage, brick NE 164.35
Iron in monument box South 16.21 Found pipe fits the monumentation of Vogelzang Brothers Subdivision

Replaced pipe with 3/4"x24" Allegan County Remonumentation iron and cap. This corner was not monumented by The original GLO Survey. This position is accepted as the best evidence of the position of the corner.


Traversed 2542 ft. on road

A-2 was approved by the Allegan County Remonumentation Peer Group on December 22, 1998.

APPROVED REMONUMENTATION CORNER
P.A. 345 OF 1990
ALLEGAN COUNTY
DATE APPROVED DEC. 22, 1998
COUNTY REP. [Signature]

C. Description of monument for corner and accessories established to perpetuate locating the position of the corner:

A-2 3/4"x24" Allegan County Remonumentation iron and cap in monument box on the East line of Section 1, Town 4 North, Range 16 West
Azimuth = Michigan State Plane grid direction
NW corner house foundation 131° 37' 96.91
NE corner house foundation 219° 16' 119.05
SE corner house foundation 300° 10' 85.90
SW corner garage 27° 45' 164.30
Centerline hydrant 34° 09' 44.54
Power pole pk in SW side 140° 53' 40.76
M-2, Town 4 North, Range 16 West 180° 19' 16.21

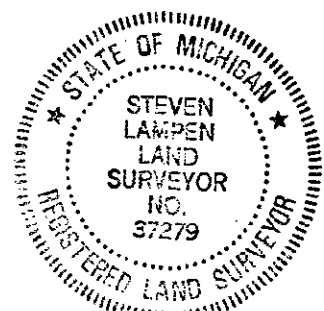

Signed by Steven Lampen

Date JANUARY 11, 1999

Surveyor's Michigan License No. 37279