

RF

MAR 07 2000

ALLEGAN COUNTY REMONUMENTATION PROGRAM
CLAND CORNER RECORDATION CERTIFICATE
Filing Requirement of Act 74, Mich. P.A. 1970

FILED

00 FEB -1 AM 8:39

For corners in SECTION

ALLEGAN
(County)

Located in: FILLMORE Corner Code #
(Township)

- 1. Public Land Survey T 4N R 15W B-9
T _____ R _____
T _____ R _____ NORTH 1/4 CORNER
T _____ R _____ SECTION 30
- 2. Property Controlling S _____ T _____ R _____
in Section S _____ T _____ R _____
- 3. Miscellaneous S _____ T _____ R _____
Property in Sec. S _____ T _____ R _____

Jayne C. Smith
REGISTER OF DEEDS
ALLEGAN COUNTY

Register of Deeds Stamp & File Number

- 4. Lot No. _____, Recorded Plat _____
- 5. Private Claims _____

I, Robert E. Lemke, surveyor, in a field survey on February 17, 1999 do hereby state that under requirements of P.A. 74, Michigan P.A. of 1970, the corner points mentioned in lines 1 and 2 above were in conformance with regulations and rules therefore as required in the current manual of survey instructions of the United States Department of the Interior, Bureau of Land Management or by a decree of a Court of Law and /or that the corner points mentioned in lines 3, 4 and 5 above were in conformance with the rules of the Michigan Board of Land Surveyors or by a Decree of a Court of Law; established, re-established, monumented, recovered, found as expressed below:

	A	B	C	D	E	F	G	H	I	J	K	L	M
1													
2	6		5		4		3		2		1		
3													
4	7		8		9		10		11		12		
5													
6	18		17		16		15		14		13		
7													
8	19		20		21		22		23		24		
9	●												
10	30		29		28		27		26		25		
11													
12	31		32		33		34		35		36		
13													

NOTE: Not more than 2 corners, all in the same town and range, may be recorded on this certificate.

A. Description of original monument and accessories and/or subsequent restoration:


SEE BACK OF SHEET FOR CORNER HISTORY

B. Description of corner evidence found and/or method applied in restoring or reestablishing corner:

- B-9**
 FOUND 1" THREADED IRON IN CENTERLINE OF ROAD
 5/8" IRON S 8° E 24.37'
 S.E. CORNER BRICK HOUSE SSW 147.77'
 N.E. CORNER BRICK HOUSE SSW 122.55'
 N.W. CORNER BRICK HOUSE SW 147.45'
 N.W. CORNER BRICK GARAGE SW 168.62'
 FOUND 1/2" IRON BAR (HEI #16042) S 33.09'

- MEASUREMENTS A-9 TO B-9 SDI= 3007.64'
 GLO=3008.94'
 WIGHTMAN=3007.52'
- MEASUREMENTS B-9 TO C-9 SDI=2634.63'
 GLO=2640'
 KVO=2634.64'

(DISTANCE TRAVERSED=5642')

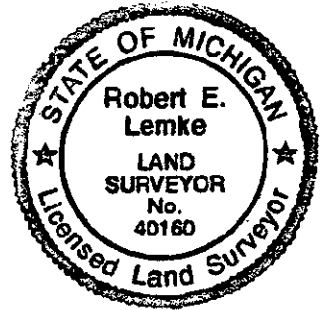

APPROVED REMONUMENTATION CORNER
P.A. 345 OF 1990
ALLEGAN COUNTY
DATE APPROVED AUG. 10, 1999
COUNTY REP. John A. Van Coten

AND IS ACCEPTED AS A CAREFUL AND FAITHFUL PERPETUATION OF THE POSITION OF THE ORIGINAL CORNER. SET 3/4" X 24" ALLEGAN COUNTY REMONUMENTATION IRON AND CAP #23520 IN GRAVEL ROAD.

PEER GROUP APPROVED AUGUST 10, 1999.

C. Description of monument for corner and accessories established to perpetuate locating the position of the corner:

B-9
SET 3/4" X 24" ALLEGAN COUNTY REMONUMENTATION IRON AND CAP #23520 IN GRAVEL ROAD.

- SET NAIL WITH ALLEGAN CO. REMON. TAG ON NORTH SIDE OF WOOD POWER POLE 12" ABOVE GROUND S 81° W 200.25'
- SET NAIL WITH ALLEGAN CO. REMON. TAG ON SOUTH SIDE OF WOOD GUY POLE 12" ABOVE GROUND N 83° W 266.28'
- CENTER OF WEST END OF A 12" DIAMETER METAL PIPE ON THE NORTH SIDE OF 140TH AVENUE N 85° E 238.42'
- CENTER OF WEST END OF A 12" DIAMETER METAL PIPE ON THE SOUTH SIDE OF 140TH AVENUE S 83° E 261.32'
- S.E. CORNER BRICK HOUSE S 20° W 147.77'
- N.E. CORNER BRICK HOUSE S 24° W 122.55'
- N.W. CORNER BRICK HOUSE S 41° W 147.45'
- N.W. CORNER BRICK GARAGE S 44° W 168.62'

Signed by Robert E. Lemke
For SDI CONSULTANTS, LTD

Date 12/30-1999
1999

Surveyor's Michigan License No. 40160

RF

MAR 07 2000

SECTION

T.4N., R.15W. B-9 CONTINUED
FILLMORE TWP

G.L.O.

WEST BETWEEN SECTIONS 19 & 30
40.00 CHAINS SET QR SEC POST
14" HEMLOCK N 67° W 23 LINKS
6" BEECH S 30°E 30 LINKS
DECEMBER 15, 1831

SECTION CARD

FD. OLD ROTTED POST "1971"
S ¼ POST SECTION 19 SET 1" IRON (IN C/L GRAVEL ROAD)
5/8" IRON NORTH 23.12'
1" IRON SOUTH 24.17'

DONALD RATEKIN, L.C.R.C. LIBER 1 PAGE 292, 4-18-72

FOUND OLD ROTTED POST
SET 1" IRON IN C/L GRAVEL ROAD
5/8" IRON N 23.12'
1" IRON S 24.17'

WIGHTMAN MOORED, INC., BOUNDARY SURVEY WITH FIELD NOTES, 7-21-91

FOUND LARGE BOLT
MEAS A-9 TO B-9 = 3007.52'

KIRK VAN ORDER, COUNTY SURVEYOR, 6-18-97

FD. 1" THREADED STEEL ROD WITH NUT
SE CORNER BRICK HSE. S.,SW 147.74'
NE CORNER BRICK HSE. S.,SW 122.51'
NW CORNER BRICK HSE. SW 147.22'
NW CORNER BRICK GARAGE SW 168.29'

LIBR0007 PAGE 244