

RF

MAR 6 7 2000

FILED

ALLEGAN COUNTY REMONUMENTATION PROGRAM
LAND CORNER RECORDATION CERTIFICATE
Filing Requirement of Act 74, Mich. P.A. 1970

SECTION

For corners in

00 FEB -1 AM 8:39

ALLEGAN (County) Located In: FILLMORE (Township) Corner Code # _____

1. Public Land Survey T 4N R 15W C-9
 T _____ R _____
 T _____ R _____ N.E. CORNER
 T _____ R _____ SECTION 30

2. Property Controlling in Section S _____ T _____ R _____
 S _____ T _____ R _____


3. Miscellaneous Property in Sec. S _____ T _____ R _____
 S _____ T _____ R _____

4. Lot No. _____, Recorded Plat _____

5. Private Claims _____

Joyce A. [Signature]
 REGISTER OF DEEDS
 ALLEGAN COUNTY, MICH.
 Register of Deeds Stamp & File Number

I, Robert E. Lemke, surveyor, in a field survey on February 17, 1999 do hereby state that under requirements of P.A. 74, Michigan P.A. of 1970, the corner points mentioned in lines 1 and 2 above were in conformance with regulations and rules therefore as required in the current manual of survey instructions of the United States Department of the Interior, Bureau of Land Management or by a decree of a Court of Law and/or that the corner points mentioned in lines 3, 4 and 5 above were in conformance with the rules of the Michigan Board of Land Surveyors or by a Decree of a Court of Law; established, re-established, monumented, recovered, found as expressed below:

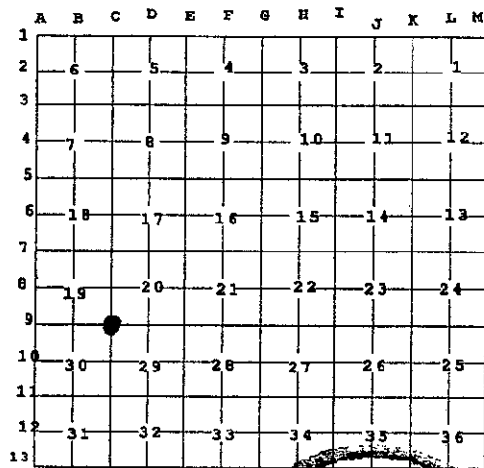


NOTE: Not more than 2 corners, all in the same town and range, may be recorded on this certificate.

A. Description of original monument and accessories and/or subsequent restoration:
 SEE BACK OF SHEET FOR CORNER HISTORY

B. Description of corner evidence found and/or method applied in restoring or reestablishing corner:
C-9
 FD. 1/2" IRON PIPE IN MONUMENT BOX
 NAIL IN N.W. SIDE POWER POLE
 NAIL IN S.W. SIDE OF CUT-OFF WOOD POLE
 N.E. CORNER BRICK HOUSE
 N.E. CORNER BRICK GARAGE
 NAIL IN N.E. SIDE POWER POLE

- N 62° E 120.39'
- S 32° E 108.88'
- S 46° W 152.13'
- S 58° W 137.15'
- N 59° W 153.87'

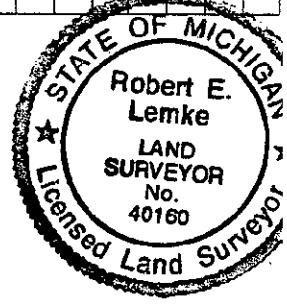

MEASUREMENTS C-9 TO C-10 SDI= 2637.96'
 GLO=2640
 (DISTANCE TRAVERSED=2638')

MEASUREMENTS B-9 TO C-9 SDI=2634.63'
 GLO=2640' KVO=2634.64'

APPROVED REMONUMENTATION CORNER
 P.A. 345 OF 1990
 ALLEGAN COUNTY
 DATE APPROVED AUG. 10, 1999.
 COUNTY REP. *[Signature]*

AND IS ACCEPTED AS A CAREFUL AND FAITHFUL **PERPETUATION** OF THE POSITION OF THE ORIGINAL CORNER. SET 3/4" X 24" ALLEGAN COUNTY REMONUMENTATION IRON AND CAP #23520 IN MONUMENT BOX.

PEER GROUP APPROVED AUGUST 10, 1999.

C. Description of monument for corner and accessories established to perpetuate locating the position of the corner:

C-9
 SET 3/4" X 24" ALLEGAN COUNTY REMONUMENTATION IRON AND CAP #23520 IN MONUMENT BOX

SET NAIL WITH ALLEGAN CO. REMON. TAG ON SOUTH SIDE OF WOOD POWER POLE 24" ABOVE GROUND. N 63° W 153.62'
 SET NAIL WITH ALLEGAN CO. REMON. TAG ON SOUTH SIDE OF WOOD POWER POLE 24" ABOVE GROUND. N 59° E 120.22'
 SET NAIL WITH ALLEGAN CO. REMON. TAG ON WEST SIDE OF BROKEN WOOD POLE 24" ABOVE GROUND. S 32° E 108.45'
 NORTHEAST CORNER BRICK HOUSE S 46° W 152.13'
 NORTHEAST CORNER BRICK GARAGE S 58° W 137.15'
 CENTERLINE OF 58TH STREET EAST 1.2'

Signed by Robert E. Lemke
 For SDI CONSULTANTS, LTD

Date 12-30-1999

Surveyor's Michigan License No. 40160

RF

MAR 07 2000

SECTION T.4N., R.15W. C-9 CONTINUED
FILLMORE TWP.

LIBER 007 PAGE 246

G.L.O.

NORTH BETWEEN SECTIONS 29 & 30

80.00 CHAINS SET POST COR SECT. 19,20,29,30

9" HEMLOCK	S 64° E	11 LINKS
6" HEMLOCK	S 60° W	9 LINKS

C-9 IS SHOWN IN TWO SURVEYS BY RATEKIN(1967 & 1970) BUT NOT WITNESSED.
TYPE OF MONUMENT IS NOT STATED.

DONALD A. RATEKIN, BOUNDARY SURVEY, 10-26-71

1/2" PIPE

ST. SIGN	S45°E	48.0'
CONC. R/W MARKER	N45°E	68.40'
CONC. R/W MARKER	S45°W	67.45'

C-9 TO C-8 = COMPUTED AS 2642.60' FROM DIMENSIONS ON SURVEY

DONALD A. RATEKIN, L.C.R.C. LIBER 1 PAGE 292, 4-18-72

PART A.

SHOWS GLO WITNESSES AS SHOWN ABOVE AND MAKES REFERENCE TO
SURVEY NOTES BY H. McDOUGAL THAT SHOW CORNER AS STONE WITH "X".

PART B.

FOUND 1/2" PIPE IN MONUMENT BOX

PART C.

FOUND 1/2" PIPE IN MONUMENT BOX

C/L ROAD		1.2'
S. SIGN	S45°E	48.0'
CONCRETE ROW MARKER	N45°E	68.40'
CONCRETE ROW MARKER	S45°W	67.45'

JAMES G. CAMPBELL, L.C.R.C. LIBER 3 PAGE 191, JULY 26, 1978

1/2" PIPE IN MON BOX

HWY ROW POST	NE	68.60'
STREET SIGN	SE	48.0'
HWY ROW POST	SW	67.65'

KIRK L. VAN ORDER, BOUNDARY SURVEY, 6-18-97

FD. 1/2" PIPE IN MON. BOX

SET NAIL IN NW SIDE P. POLE	NE	120.37'
SET NAIL IN SW SIDE CUT-OFF P. POLE	SE	108.85'
NE COR BRICK HOUSE	SW	152.22'
SET NAIL IN NE SIDE P. POLE	NW	153.86'

SURVEY SHOWS A DISTANCE OF 2634.635' FROM B-9 TO C-9.