ALLEGAN COUNTY REMONUMENTATION

LAND CORNER RECORDATION CERTIFICATE

Filing Requirement of Act 74, Mich. P.A. 1970

For corners in Allegan (County)

		Located In:	Corner Code #
1. Public Land Survey		T 4N R 15W	H-1 (N 1/4 Sec 3)
		T ___ R ___	Fillmore Twp.
		T ___ R ___	
		T ___ R ___	
2. Property Controlling	S ___	T ___ R ___	
in Section	S ___	T ___ R ___	
3. Miscellaneous	S ___	T ___ R ___	
Property in Sec.	S ___	T ___ R ___	

1993 DEC 30 PM 5

FILED

Register of Deeds Stamp & File Number

4. Lot No. _____ , Recorded Plat _____

5. Private Claims _____

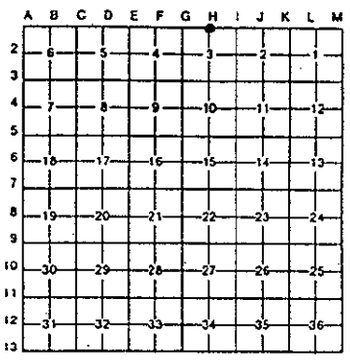

I, David R. Greer, in a field survey on November 23, 19 93, do hereby certify that under requirements of P.A. 74, Michigan P.A. of 1970, the corner points mentioned in lines 1 and 2 above were in conformance with regulations and rules therefore as required in the current manual of survey instructions of the United States Department of the Interior, Bureau of Land Management or by a decree of a Court of Law and/or that the corner points mentioned in lines 3, 4 and 5 above were in conformance with the rules of the Michigan Board of Land Surveyors or by a Decree of a Court of Law; established, re-established, monumented, re-monumented, recovered, found as expressed below:

NOTE: **Not more than 4 corners, all in the same town and range, may be recorded on this certificate.**

A. Description of original monument and accessories and/or subsequent restoration:

H-1 This corner not set by the Government
Recorded in Liber 4, Page 65, March 16, 1990
Found 1/2" iron with cap (N 1/4 corner)

O.C. mon S 1/4 corner Sec. 34	E	127.16'
1/2" iron	S	43.03'
Nail & tag W Side 40" Beech	S	35.35'
Nail & tag SW 15" Elm	SE	46.55'

B. Description of corner evidence found and/or method applied in restoring or reestablishing corner:

H-1
Set A.C. Remonumentation Iron & Cap on South line of Section 34, from above witnesses andprevious Section line measurements and surveys made by Holland Engineering, Inc. using this corner. This position not established by original government surveyors. This monument is accepted as the best available evidence of the position of the corner

Ottawa County Monument S 1/4 corner Sec 34.	E	127.15'
15" Elm	SE	46.45'

C. Description of monument for corner and accessories established to perpetuate locating the position of the corner:

H-1
A.C. Remon Iron & Cap on South line, Sec. 34, T5N, R15W
AZ = Michigan State Grid Direction

O.C. Remon iron & cap H-13(S1/4Sec 34 T5NR15W)	AZ.	90°33'	127.15
A.C. Remon tag & nail in NW Side 18" Ash	AZ.	63°34'	114.24'
A.C. Remon tag & nail in SW Side 16" Ash	AZ.	115°11'	108.04'
A.C. Remon tag & nail in S Side 30" Ash	AZ.	300°59'	122.65'
A.C. Remon tag & nail in NE Side 14" Ash	AZ.	145°35'	46.45'

STATE OF MICHIGAN
DAVID R. GREER
LAND SURVEYOR
No. 16042
REGISTERED LAND SURVEYOR

Signed by David R. Greer Date 11/23/93

Surveyor's Michigan License No. 16042

FORM APPROVED BY MICHIGAN STATE BOARD OF LAND SURVEYORS, JAN. 28, 1971
REVISED MAY 14, 1975
REVISED JAN., 1983

W:\Decs\Serv\Remon.doc