

**ALLEGAN COUNTY REMONUMENTATION  
LAND CORNER RECORDATION CERTIFICATE**  
Filing Requirement of Act 74, Mich. P.A. 1970

LIBR0006 PAGE 371

For corners in <u>Allegan</u> <small>(County)</small>	Located In:	Corner Code #
1. Public Land Survey	T4N__ R15W__	J-13
	T____ R____	
	T____ R____	South 1/4 cor. Sec.
	T____ R____	35, Fillmore Twp.
2. Property Controlling in Section	S____ T____ R____	
	S____ T____ R____	
3. Miscellaneous Property in Sec.	S____ T____ R____	
	S____ T____ R____	
4. Lot No. _____, Recorded Plat _____		
5. Private Claims _____		

FILED  
1/28/1999 2:44:39 PM  
JOYCE A. WATTS  
REGISTER OF DEEDS  
ALLEGAN COUNTY, MICH  
**Register of Deeds Stamp & File Number**

I, Steve Lampen \_\_\_\_\_, in a field survey on December 4, 1998, do hereby certify that under requirements of P.A. 74, Michigan P.A. of 1970, the corner points mentioned in lines 1 and 2 above were in conformance with regulations and rules therefore as required in the current manual of survey instructions of the United States Department of the Interior, Bureau of Land Management or by a decree of a Court of Law and/or that the corner points mentioned in lines 3, 4 and 5 above were in conformance with the rules of the Michigan Board of Land Surveyors or by a Decree of a Court of Law; established, re-established, monumented, re-monumented, recovered, found as expressed below:

**NOTE: Not more than 4 corners, all in the same town and range, may be recorded on this certificate.**

**A. Description of original monument and accessories and/or subsequent restoration:**

J-13	Consumers Power Co.
GLO - Lyon-Sibley - 1831	Iron found
Set HMP	16" Coffee NE 41.5
Cherry 7 N 78 E 53	16" Coffee NE 23.4
Beech 9 N 73 W 15	15" Maple NE 59.51
	13" Maple ENE 62.45
Hicks 1876	J-1 to I-1 2633.71
Stone	J-1 to K-1 2638.10

Road Commission	Survey L1186, P193 - VanOrder - 1986
Iron and stones	20" shag Hickory N 114.05
SW cor. foundation school NE 90.2	20" Maple NE 60.30
6" Basswood N 19.8	Telephone pole SE 88.32
8" Elm NW 42	Centerline 6" tree SW 69.8

**B. Description of corner evidence found and/or method applied in restoring or reestablishing corner:**

J-13 Found 3/4" iron in monument box	16" Coffee NE 41.5	20" Maple NE 60.30
15" Maple NE 59.51	20" Shag Hickory N 114.05	20" Maple NE 60.30
Telephone pole SE 88.32	J-13 to I-13 measured 2633.58	J-13 to K-13 measured 2638.33

Iron is on occupation line towards the North.

Replaced found iron with 3/4"x24" Allegan County Remonumentation iron and cap and is accepted as a careful and faithful perpetuation of the position of the original corner.

This corner was approved by the Allegan County Remonumentation Peer Group on December 8, 1998.


**APPROVED REMONUMENTATION CORNER**  
P.A. 345 OF 1990  
ALLEGAN COUNTY  
DATE APPROVED DEC. 8, 1998  
COUNTY REP. [Signature]

**C. Description of monument for corner and accessories established to perpetuate locating the position of the corner:**

J-13 3/4"x24" Allegan County Remonumentation iron and cap in monument box.

Azimuth = Michigan State Plane grid direction

NW corner house, brick	246° 16'	228.56
SE corner house, brick	139° 12'	158.29
SW corner house, brick	42° 40'	116.15
SW corner house, vinyl siding	310° 45'	253.54
J-1, Town 3 North, Range 15 West	271° 11'	17.08

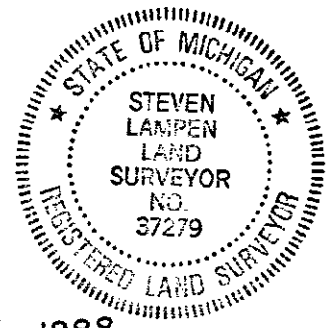

Signed by Steven Lampen

Date JANUARY 11, 1999

Surveyor's Michigan License No. 37279