

**ALLEGAN COUNTY REMONUMENTATION
LAND CORNER RECORDATION CERTIFICATE
Filing Requirement of Act 74, Mich. P.A. 1970**

LIBRNO 006 PAGE 374

For corners in Allegan (County) Located In: _____ Corner Code # _____

1. Public Land Survey T4N ___ R15W ___ K-13
 T ___ R ___
 T ___ R ___ SW corner, Section
 T ___ R ___ 36, Fillmore Twp.

2. Property Controlling S ___ T ___ R ___
 in Section S ___ T ___ R ___

3. Miscellaneous S ___ T ___ R ___
 Property in Sec. S ___ T ___ R ___

4. Lot No. _____ Recorded Plat _____

5. Private Claims _____

FILED
1/28/1999 2:44:39 PM
JOYCE A. WATTS
Register of Deeds Stamp & File Number
ALLEGAN COUNTY, MICH

I, Steve Lampen, in a field survey on December 4, 1998, do hereby certify that under requirements of P.A. 74, Michigan P.A. of 1970, the corner points mentioned in lines 1 and 2 above were in conformance with regulations and rules therefore as required in the current manual of survey instructions of the United States Department of the Interior, Bureau of Land Management or by a decree of a Court of Law and/or that the corner points mentioned in lines 3, 4 and 5 above were in conformance with the rules of the Michigan Board of Land Surveyors or by a Decree of a Court of Law; established, re-established, monumented, re-monumented, recovered, found as expressed below:

NOTE: Not more than 4 corners, all in the same town and range, may be recorded on this certificate.

1	A	B	C	D	E	F	G	H	I	J	K	L	M
2	6	5	4	3	2	1							
3													
4	7	8	9	10	11	12							
5													
6	18	17	16	15	14	13							
7													
8	19	20	21	22	23	24							
9													
10	30	29	28	27	26	25							
11													
12	31	32	33	34	35	36							
13													

A. Description of original monument and accessories and/or subsequent restoration:
 K-13 Consumers Power Co. L.C.R.C. L4, P407 - Greer - 1994
 GLO - Lyon-Sibley -1832 Found 3/4" iron Found 3/4" iron in monument box
 set P corner Sec.'s 35 & 36 41" Maple WSW 52.6 Power pole N 11° W 177.86
 Hickory 28 N 72 E 30 Street sign S 15.32 Power pole N 77° W 176.45
 Sugar 4 N 47 W 27 Telephone pole SW 43.48 12" twin Cherry S 6° E 219.52
 17" Maple WNW 83.69 Power pole S 79° E 167.49
 Hicks - 1876 K-13 to K-12 2651.22 Iron in monument box (K-1, T3N, R15W) E 19.8
 Stone K-13 to J-13 2638.1

K-13 is shown on Walnut Park Subdivision

B. Description of corner evidence found and/or method applied in restoring or reestablishing corner:
 K-13 Found 3/4" iron in monument box
 Telephone pole SW 42.83 Power pole N 11° W 177.86
 Power pole S 79° E 167.49 Iron in monument box E 19.8

Found iron fits the monumentation of Walnut Park Subdivision


K-13 to K-12 rec. = 2651.22 measured = 2651.22 K-13 to J-13 rec. = 2638.1 measured = 2638.33

Replaced iron with a 3/4"x24" Allegan County Remonumentation iron and cap and is accepted as a careful and faithful perpetuation of the position of the original corner.

This corner was approved by the Allegan County Remonumentation Peer Group on December 8, 1998.

APPROVED REMONUMENTATION CORNER
P.A. 345 OF 1990
ALLEGAN COUNTY
DATE APPROVED DEC. 8, 1998
COUNTY REP. Steve Lampen

C. Description of monument for corner and accessories established to perpetuate locating the position of the corner:
 K-13 3/4"x24" Allegan County Remonumentation iron and cap in monument box
 Azimuth - Michigan State Plane grid direction
 NW corner house, brick 128° 53' 139.67'
 NE corner building, foundation 223° 07' 209.17'
 NE corner house, brick 252° 15' 232.99'
 SE corner house, foundation 40° 27' 172.64'
 Power pole, remonumentation tag E side 351° 01' 177.97'
 K-1, Town 3 North, Range 15 West 91° 32' 19.80'
 Centerline E & W asphalt road pavement 180° 1.0'
 Centerline asphalt road pavement towards N 270° 0.7'

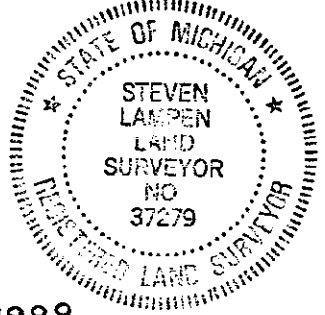

Signed by Steven Lampen Date JANUARY 11, 1999

Surveyor's Michigan License No. 37279