

APR 0 7 1998

OCOTION	LAND CO	RNER RECORDATION (CERTIFICATE		
SECTION For corners in		quirement of Act 74, Mi		00	98
Allegan (County)	Located in:	Corner Code ≠≠		در دون چرکی	
1. Public Land Survey	T 4N R 141 T R T 4N R 151	W Querisel Twp M-1)(NE, 1)		SAN COUNTY P	FILED JAN 21 PH I
2. Property Controlling	T R S T R	rillmore Twp	'	5.5	
in Section	S T R			Q.	27
Miscellaneous Property in Sec.	S T R S T R	-	— Regi	ster of Deeds Stam	p & File Number
			<u> </u>		
4. Lot No,	Recorded Plat			ABCDEF	- G H t J K L
I. John C. Bueche do hereby certify that underre in lines 1 and 2 above were current manual of survey insti Management or by a decree of	in a field survey on equirements of P.A. 74, Michigan in conformance with regulation ructions of the United States Or a Court of Law and/or that the c ith the rules of the Michigan Bo.	
Court of Law; established,	re-established, monumented.	re-monumented, recovered	, found as	%	
expressed below:				10 - 30 - 29 - 28	272625-
on this certificate	corners, all in the same tow	n and range, may be reco		11 12 11 11	
				13	34 35 36
	monument and accessories				
A-1 GLO Oct. 29, 183		L3, P393	Card file PP NW 70.8	Q1	
Lucius Lyon,			St. sign NW		
80.00 set ten		V 71.00'	PP SSW 16		
cor. post		58.65	TP NE 44.2		
001. p031		V 165.40'	TP SSE 106		
	Solid i	ron in mon. box 0.19' N¼ 6			
	evidence found and/or meth ottawa Co. Mon. in Mon.	Box @ C/L X (iron E :		orner:	
Meas East 2	AS per 2140,20' N¼ 6	r above wit.			
Micas. Last 2	.140.20 1474 0				
And is accep	ted as a careful and fait	hful perpetuation of th	e position of t	he original corne	г.
Peer group	approved May 13, 19	997•	APPR	OVED REMONUMENT. P.A. 345 OF 19 ALLEGAN COU	90
			DATI	BAPPROVED _ 5 -	<u>3-97</u>
			COU	NTY REPK	V.O.
C. Description of manual	ent for corner and accessori	ias astablisheri to nernetu	ate location the	position of the corr	nar
		•	are localing the	position of the con	iĢi,
C/L hydt, N s	Co. Mon. with alum. cap 50° E 63.26' ra Co. Remon. Tag in S		a.	William Ol B.	AMA TON
Nail & Ottaw Nail & Ottaw Nail & Allega	ra Co. Remon. Tag in S ra Co. Remon. Tag in W an Co. Remon. Tag in W	side GP S 57° E 58.7 side PP S 20° W 165	4' 5.37'	JOHN * BUECI	HE **
Iron East 20 On C/L bit. I				JOHN BUECI LANG	7 July
	1000	l.		- CM	X
Signed by John C. Bue	che, P.S.	heDat	e 10-26	-4-7	
Surveyor's Michigan Licens	se No. 13027	G1 - 1 - 1 - 1	FORM APPROVE	O BY MICHIGAN STATE BOARD O	F LAND SURVEYORS, JAN. 28, 18
1000	16175	Sheet 1 of 2			REVISEO MAY 14, 15 BEVISEO JAN., 18

Allegan County Remonumentation

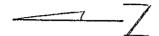

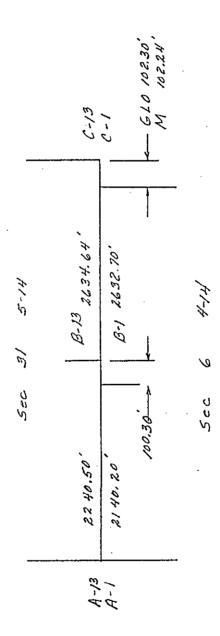

···