

**ALLEGAN COUNTY REMONUMENTATION
LAND CORNER RECORDATION CERTIFICATE
Filing Requirement of Act 74, Mich. P.A. 1970**

LIBERO 006 PAGE 376

For corners in
Allegan
(County)

Located In: _____ Corner Code # _____

1. Public Land Survey T4N R15W M-6
T _____ R _____
T _____ R _____
T _____ R _____

2. Property Controlling S _____ T _____ R _____
in Section S _____ T _____ R _____

3. Miscellaneous S _____ T _____ R _____
Property in Sec. S _____ T _____ R _____

4. Lot No. _____, Recorded Plat _____

5. Private Claims _____

FILED
1/28/1999 2:44:39 PM
JOYCE A. WATTS
REGISTER OF DEEDS
ALLEGAN COUNTY, MICH
Register of Deeds Stamp & File Number

I, Steve Lampen, in a field survey on December 19, 1998, do hereby certify that under requirements of P.A. 74, Michigan P.A. of 1970, the corner points mentioned in lines 1 and 2 above were in conformance with regulations and rules therefore as required in the current manual of survey instructions of the United States Department of the Interior, Bureau of Land Management or by a decree of a Court of Law and/or that the corner points mentioned in lines 3, 4 and 5 above were in conformance with the rules of the Michigan Board of Land Surveyors or by a Decree of a Court of Law; established, re-established, monumented, re-monumented, recovered, found as expressed below:

| | | | | | | | | | | | | | |
|----|---|----|----|----|----|----|----|---|---|---|---|---|---|
| 1 | A | B | C | D | E | F | G | H | I | J | K | L | M |
| 2 | | 6 | 5 | 4 | 3 | 2 | 1 | | | | | | |
| 3 | | | | | | | | | | | | | |
| 4 | | 7 | 8 | 9 | 10 | 11 | 12 | | | | | | |
| 5 | | | | | | | | | | | | | |
| 6 | | 18 | 17 | 16 | 15 | 14 | 13 | | | | | | |
| 7 | | | | | | | | | | | | | |
| 8 | | 19 | 20 | 21 | 22 | 23 | 24 | | | | | | |
| 9 | | | | | | | | | | | | | |
| 10 | | 30 | 29 | 28 | 27 | 26 | 25 | | | | | | |
| 11 | | | | | | | | | | | | | |
| 12 | | 31 | 32 | 33 | 34 | 35 | 36 | | | | | | |
| 13 | | | | | | | | | | | | | |

NOTE: Not more than 4 corners, all in the same town and range, may be recorded on this certificate.

A. Description of original monument and accessories and/or subsequent restoration:

| | | |
|--|---|---|
| M-6 GLO - Lyon-Sibley - 1831 Set HMP Hemlock 30 N 5 W 50 Hemlock 30 S 31 W 7 | Allegan County Surveyors Witness Card - no date East 1/4 post - iron Iron West 50.0 Iron East 50.0 | D. A. Ratekin & Associates, Inc. Job No. 75-3047 December 30, 1975 E 1/4 post Sec. 13, T4N, R15W Found Steel bar in mon. box Centerline S end metal culvert W 31.00 Centerline N end metal culvert NW 41.05 |
| A. Gardner October 24, 1879 Stake and witness M-7 South 2654.52 | L.C.R.C. - L2, P186 John P. Clapp October 29, 1973 Found steel bar in mon. box Centerline S end metal culvert W 31.00' Centerline N end metal culvert NW 41.05 Overisel cor. (W 1/4 cor. Sec. 18-4-14) South 54.10 | Kirk VanOrder Recorded Survey, L1027, P716 Job No. 82-155 December 12, 1982 E 1/4 cor. Sec. 13, T4N, R15W Found steel bar in mon. box (no ties) |

See Page 2 of 2

B. Description of corner evidence found and/or method applied in restoring or reestablishing corner:
M-6 Found 3/4" Iron in monument box Centerline N end CMP WN 41.24
Centerline S end CMP W 30.76 Iron in monument box S 54.1

M-6 was accepted by the Allegan County Remonumentation Peer Group on December 22, 1998


Replaced iron with 3/4"x24" Allegan County Remonumentation iron and cap and accepted it as a careful and faithful perpetuation of the position of the original corner.

APPROVED REMONUMENTATION CORNER
P.A. 345 OF 1990
ALLEGAN COUNTY
DATE APPROVED DEC. 22, 1998
COUNTY REP. [Signature]

C. Description of monument for corner and accessories established to perpetuate locating the position of the corner:

M-6 3/4"x24" Allegan County Remonumentation iron and cap in monument box
Azimuth = Michigan State Plane Grid direction

| | | | |
|---|------|-----|--------|
| Power pole, remonumentation tag in W side | 11° | 35' | 144.0 |
| Power pole, remonumentation tag in W side | 2° | 20' | 536.62 |
| Power pole, remonumentation tag in W side | 171° | 46' | 259.17 |
| A-6, Town 4 North, Range 14 West | 179° | 07' | 54.08 |
| Centerline N and S asphalt road pavement | 270° | | 0.1' |

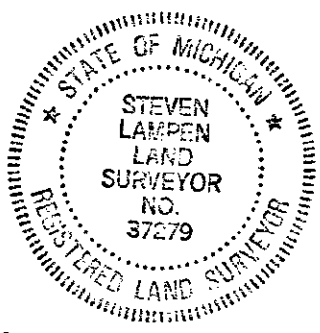

Signed by Steven Lampen Date JANUARY 11, 1999
Surveyor's Michigan License No. 37279

A. Description of original monument and accessories and/or subsequent restoration:

Kirk VanOrder
Job No. 87-1423
September 1, 1987
E 1/4 corner
Sec. 13, T4N, R15W
Found boat spike in mon. box
Centerline N end CMP NW 41.24
Centerline S end CMP W 30.76
Centerline 3" Aspen WSW 34.74
Iron in mon. box S 54.08

LIBERO 006 PAGE 377

SECTION
SECTION
SECTION