

**ALLEGAN COUNTY REMONUMENTATION
LAND CORNER RECORDATION CERTIFICATE
Filing Requirement of Act 74, Mich. P.A. 1970**

For corners in Allegan Located In: _____ Corner Code # _____
(County)

1. Public Land Survey T4N R15W M-7
T R
T R Northeast corner
T R Section 24
2. Property Controlling S T R Fillmore Twp.
in Section S T R
3. Miscellaneous S T R
Property in Sec. S T R

4. Lot No. _____, Recorded Plat _____
5. Private Claims _____

FILED
1/28/1999 2:44:39 PM
JOYCE A. WATTS
REGISTER OF DEEDS
ALLEGAN COUNTY, MICH
Register of Deeds Stamp & File Number

LIBERO 006 PAGE 378

I, Steve Lampen, in a field survey on December 19, 1998, do hereby certify that under requirements of P.A. 74, Michigan P.A. of 1970, the corner points mentioned in lines 1 and 2 above were in conformance with regulations and rules therefore as required in the current manual of survey instructions of the United States Department of the Interior, Bureau of Land Management or by a decree of a Court of Law and/or that the corner points mentioned in lines 3, 4 and 5 above were in conformance with the rules of the Michigan Board of Land Surveyors or by a Decree of a Court of Law; established, re-established, monumented, re-monumented, recovered, found as expressed below:

1	A	B	C	D	E	F	G	H	I	J	K	L	M
2	6	5	4	3	2	1							
3													
4	7	8	9	10	11	12							
5													
6	18	17	16	15	14	13							
7													
8	19	20	21	22	23	24							
9													
10	30	29	28	27	26	25							
11													
12	31	32	33	34	35	36							
13													

NOTE: Not more than 4 corners, all in the same town and range, may be recorded on this certificate.

A. Description of original monument and accessories and/or subsequent restoration:
M-7 Allegan County Surveyor Witness card
GLO - Lyon-Sibley - 1831 Section 13
Set P corner Section 13 & 24 Section 13
Sugar 6 N 18 1/2 W 37 Southeast corner
Beech 14 S 33 West 48 60" Oak SSW 206.89
Allegan County Surveyor Witness card
Section 24
NE cor. 1" iron
N end 12" CMP E 23.5
S end 12" CMP SE 38.5
Centerline power pole NE 145.86
Centerline gas line S 312'
In centerline gravel road

A. Gardner Holland Engineering, Inc.
October 24, 1879 Section Sheet
Stone and stake M-6 to m-7 North 2647.16
M-6 North 2654.52
Donald A. Ratekin & Associates
Section Sheet
M-6 to M-7 North 2647.28

B. Description of corner evidence found and/or method applied in restoring or reestablishing corner:
M-7 Found 3/4" iron
Centerline S end CMP SE 38.87 Centerline N end CMP E 23.47 Iron S 43.56
M-7 to M-6 meas. = 2647.16 A-7 to A-9 meas. = 5273.75 A-7 to B-7 meas. = 2238.12


Replaced 3/4" iron with 3/4"x24" Allegan County Remonumentation iron and cap and accepted it as a careful and faithful perpetuation of the position of the original corner.

M-7 was approved by the Allegan County Remonumentation Peer Group on December 22, 1998.

APPROVED REMONUMENTATION CORNER
P.A. 345 OF 1990
ALLEGAN COUNTY
DATE APPROVED DEC. 22, 1998
COUNTY REP. [Signature]

C. Description of monument for corner and accessories established to perpetuate locating the position of the corner:
M-7 3/4"x24" Allegan County Remonumentation iron and cap
Azimuth = Michigan State Plane grid direction

Power pole, remonumentation tag in W side	172°	51'	590.31
Power pole, remonumentation tag in W side	163°	32'	246.57
Power pole, remonumentation tag in W side	27°	15'	145.35
SE corner garage, brick	352°	56'	999.09
A-7, Town 4 North, Range 14 West	179°	36'	43.56
Centerline N and S gravel road	270°		0.

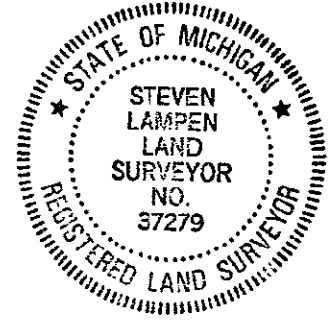

Signed by Steven Lampen Date JANUARY 11, 1999
Surveyor's Michigan License No. 37279

A. Continued
Kirk VanOrder
Job No. 87-1423
September 1, 1987
SE cor. Section 13
Found 1" iron rod
Centerline S end CMP SE 38.87
Centerline N end CMP E 23.47
1" iron S 43.42
M-6 to M-7 North 2647.16

SECTION