

**ALLEGAN COUNTY REMONUMENTATION
LAND CORNER RECORDATION CERTIFICATE
Filing Requirement of Act 74, Mich. P.A. 1970**

LIBERO 006 PAGE 382

For corners in Allegan (County) Located In: _____ Corner Code # _____

1. Public Land Survey T4N R15W M-10
 T R
 T R
 T R
 T R

2. Property Controlling S T R
 in Section S T R
 Property in Sec. S T R

4. Lot No. _____ Recorded Plat _____
 5. Private Claims _____

FILED
1/28/1999 2:44:39 PM
JOYCE A. WATTS
REGISTER OF DEEDS
ALLEGAN COUNTY, MICH
Register of Deeds Stamp & File Number

I, Steve Lampen, in a field survey on December 19, 1998, do hereby certify that under requirements of P.A. 74, Michigan P.A. of 1970, the corner points mentioned in lines 1 and 2 above were in conformance with regulations and rules therefore as required in the current manual of survey instructions of the United States Department of the Interior, Bureau of Land Management or by a decree of a Court of Law and/or that the corner points mentioned in lines 3, 4 and 5 above were in conformance with the rules of the Michigan Board of Land Surveyors or by a Decree of a Court of Law; established, re-established, monumented, re-monumented, recovered, found as expressed below:

1	A	B	C	D	E	F	G	H	I	J	K	L	M
2	6	5	4	3	2	1							
3													
4	7	8	9	10	11	12							
5													
6	18	17	16	15	14	13							
7													
8	19	20	21	22	23	24							
9													
10	30	29	28	27	26	25							
11													
12	31	32	33	34	35	36							
13													

NOTE: Not more than 4 corners, all in the same town and range, may be recorded on this certificate.

A. Description of original monument and accessories and/or subsequent restoration:

M-10	Consumers Power Co. - 1968	Survey - VanOrder - 1991
GLO - Lyon-Sibley -1831	Section	Found iron in monument box
Set HMP	Power pole W 215.9'	Centerline 4" pipe W 33.60
Beech 22 N 38 W 19	Reflector NNW 198.97	Power pole W 217.20
Beech 24 S 70 W 29	Centerline road W 2'	Power pole NW 224.10
	Occupation line S 3.5'	Iron in monument box S 30.33
Hicks - 1876	NOTE: West line is straight line	
Stone		
M-11 40 chains	M-9 N 01° 01' 05" E 2635.73	
	M-11 S 01° 01' 05" W 2635.74	
	A-10 (T4N, R14W) S 01° 01' 05" W 30.16	

B. Description of corner evidence found and/or method applied in restoring or reestablishing corner:

M-10 Found 1/2" iron in monument box Iron in Monument box South 30.33
 Occupation line to West is 3' South Power pole W rec. = 215.9 measured = 217.7
 M-10 to M-11 rec. = 2635.74 measured 2636.18 M-10 to M-9 rec. = 2635.73 measured = 2635.25
 M-10 is 8.6' East of M-9 to M-11

Replaced 1/2" iron with 3/4"x24" Allegan County Remonumentation iron and cap and accepted it as a careful and faithful perpetuation of the position of the original corner.


M-10 was approved by the Allegan County Remonumentation Peer Group on December 22, 1998.

APPROVED REMONUMENTATION CORNER
 P.A. 345 OF 1990
 ALLEGAN COUNTY
 DATE APPROVED DEC 22, 1998
 COUNTY REP. [Signature]

C. Description of monument for corner and accessories established to perpetuate locating the position of the corner:

M-10 3/4"x24" Allegan County Remonumentation iron and cap in monument box
 Azimuth = Michigan State Plane grid direction
 Power pole, remonumentation tag in SE side
 SE corner house foundation

Power pole, remonumentation tag in SE side	336° 02'	224.08
SE corner house foundation	286° 29'	389.45
Power pole, remonumentation tag in N side	271° 48'	217.69
Power pole, remonumentation tag in E side	183° 25'	472.02
Centerline N & S asphalt road pavement	270°	0.
A-10, Town 4 North, Range 14 West	180° 18'	30.33

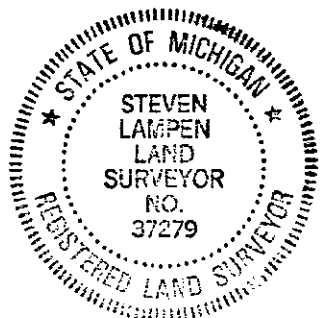

Signed by Steven Lampen Date JANUARY 11, 1999
 Surveyor's Michigan License No. 37279