

**ALLEGAN COUNTY REMONUMENTATION  
LAND CORNER RECORDATION CERTIFICATE**  
Filing Requirement of Act 74, Mich. P.A. 1970

For corners in <u>Allegan</u> (County)	Located In:	Corner Code #
1. Public Land Survey	T4N R15W	M-11
	T R	
	T R	Northeast corner,
	T R	Section 36, Fillmore
2. Property Controlling in Section	S T R	Twp.
	S T R	
3. Miscellaneous Property in Sec.	S T R	
	S T R	
4. Lot No. _____, Recorded Plat _____		
5. Private Claims _____		

FILED  
1/28/1999 2:44:39 PM  
JOYCE A. WATTS  
REGISTER OF DEEDS  
ALLEGAN COUNTY, MICH

Register of Deeds Stamp & File Number

LIBERO 006 PAGE 33

I, Steven Lampen, in a field survey on December 19, 1998, do hereby certify that under requirements of P.A. 74, Michigan P.A. of 1970, the corner points mentioned in lines 1 and 2 above were in conformance with regulations and rules therefore as required in the current manual of survey instructions of the United States Department of the Interior, Bureau of Land Management or by a decree of a Court of Law and/or that the corner points mentioned in lines 3, 4 and 5 above were in conformance with the rules of the Michigan Board of Land Surveyors or by a Decree of a Court of Law; established, re-established, monumented, re-monumented, recovered, found as expressed below:

**NOTE: Not more than 4 corners, all in the same town and range, may be recorded on this certificate.**

1	A	B	C	D	E	F	G	H	I	J	K	L	M
2	6	5	4	3	2	1							
3													
4	7	8	9	10	11	12							
5													
6	18	17	16	15	14	13							
7													
8	19	20	21	22	23	24							
9													
10	30	29	28	27	26	25							
11													
12	31	32	33	34	35	36							
13													

**A. Description of original monument and accessories and/or subsequent restoration:**

M-11	Consumers Co. - 1968	Survey - VanOrder - 1991
GLO - Lyon-Sibley - 1831	Found 1/4" pipe	Found 3/4" re-rod in monument box
Set P corn. Sections 25 & 36	SW corner Section 30 N 33'	Spike in SW face 10" Cherry SE 50.60
Beech 6 S 11 W 15	Street sign E 13.6	Centerline S leg warning sign ESE 20.60
Beech 8 N 47 W 21	30" Maple SE 29.55	Iron in monument box S 33.01
	3" Basswood ENE 13.32	Centerline Street & Stop sign SW 48.11
Hicks - 1876	M-11 to L-11 = 2618.35	Centerline West end CMP NW 92.92
Stone	M-11 to M-9 = 5271.47	Centerline East end CMP NE 95.61

**L.C.R.C. - L3, P243 - Clapp - 1978**

Found 1 1/2" pipe  
Overisel corner S 33.0  
5" Maple NE 32.75  
8" Elm E 19.50  
18" Maple SE 64.53  
Centerline Street sign ESE 13.6

**B. Description of corner evidence found and/or method applied in restoring or reestablishing corner:**

M-11 Found 3/4" iron in monument box Iron in monument box S 33.0'  
18" Maple Se 64.53 M-11 to L-11 rec. 2618.35, measured 2618.3 M-11 to M-9 rec. 5271.47 measured 5271.4

Replaced 3/4" iron with 3/4"x24" Allegan County Remonumentation iron and cap and is accepted as a careful and faithful perpetuation of the position of the original corner.


Approved by the Allegan County Remonumentation Peer Group on December 22, 1998.

**APPROVED REMONUMENTATION CORNER**  
P.A. 345 OF 1990  
ALLEGAN COUNTY  
DATE APPROVED DEC. 22, 1998  
COUNTY REP. [Signature]

**C. Description of monument for corner and accessories established to perpetuate locating the position of the corner:**

M-11 3/4"x24" Allegan County Remonumentation iron and cap in monument box.  
Azimuth = Michigan State Plane grid direction

Twin 16" Maple, Remonumentation tag in SW side	124° 55'	64.81
NE corner house, brick	216° 10'	346.38
Power pole, remonumentation tag in N side	262° 56'	256.20
SE corner house, brick	335° 57'	625.42
A-11, Town 4 North, Range 14 West	180° 12'	33.02

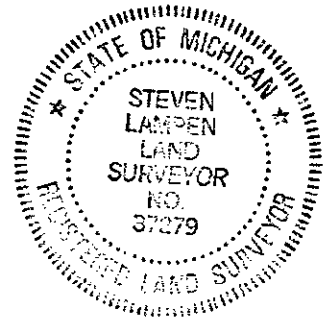

Signed by Steven Lampen Date JANUARY 11, 1999

Surveyor's Michigan License No. 37279