

COPY

ALLEGAN COUNTY REMONUMENTATION
LAND CORNER RECORDATION CERTIFICATE
Filing Requirement of Act 74, Mich. P.A. 1970

For corners in

<u>Allegan</u> (County)	Located in:	Corner Code #
1. Public Land Survey	T 3N R 14W * A-1 Heath Twp.	
	T 4N R 14W A-13 Overisel Twp.	
	T 3N R 15W M-1 Manlius Twp.	
2. Property Controlling in Section	T 4N R 15W * M-13 Fillmore Twp.	
3. Miscellaneous Property in Sec.	S ___ T ___ R ___	
	S ___ T ___ R ___	
	S ___ T ___ R ___	
	S ___ T ___ R ___	


97 JAN 22 PM 1:23
 REGISTER OF DEEDS
 ALLEGAN COUNTY, MICHIGAN
 FILED

Register of Deeds Stamp & File Number

4. Lot No. _____, Recorded Plat _____
 5. Private Claims _____

I, Kirk L. Van Order, in a field survey on May 5, 1996, do hereby state that under requirements of P.A. 74, Michigan P.A. of 1970, the corner points mentioned in lines 1 and 2 above were in conformance with regulations and rules therefore as required in the current manual of survey instructions of the United States Department of the Interior, Bureau of Land Management or by a decree of a Court of Law and/or that the corner points mentioned in lines 3, 4 and 5 above were in conformance with the rules of the Michigan Board of Land Surveyors or by a Decree of a Court of Law, established, re-established, monumented, recovered, found as expressed below:

NOTE: Not more than 2 corners, all in the same town and range, may be recorded on this certificate.

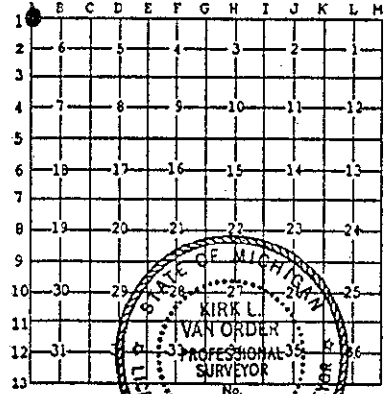

A. Description of original monument and accessories and/or subsequent restoration:

- A-1
- (1) GLO surveyed in 1831 by L. Lyon D.S. West on S side of Sec. 31, T.4N., R.14W. 77.02 chains to range line 5.01 links N of temp. point and set post corner to Town 3 & 4 North, Ranges 14 & 15 West
 Sugar 12 in. dia. S62°W 17 lks
 Beech 8 in. dia. N46°E 17 lks
 - (2) A. Gardner Co. Surveyor May 14, 1880 survey notes show iron at SW corner Sec. 31, T.4N., R.14W. (continued on back of sheet)

B. Description of corner evidence found and/or method applied in restoring or reestablishing corner.

A-1
 Kirk L. Van Order Remon. survey dated May 5, 1996
 Fd. 3/4" iron over stone in mon. box using ties as listed in (1)
 Part "A" and is accepted as a careful and faithful perpetuation of the position of the original corner.

Peer group approved May 14, 1996.

APPROVED REMONUMENTATION CORNER
 P.A. 345 OF 1990
 ALLEGAN COUNTY
 DATE APPROVED 5-14-96
 COUNTY REP. Kirk L. Van Order

C. Description of monument for corner and accessories established to perpetuate locating the position of the corner.

- A-1
- Removed iron and set standard Allegan Co. Remon. monument (3/4" x 11" steel rod w/red cap #23520) in concrete over stone in mon. box
 - Nail & Remon. tag in W side power pole N20°E 80.00'
 - Nail & Remon. tag in SW side tele. pole S30°E 45.61'
 - Nail & Remon. tag in SE side support pole S45°W 43.95'
 - Nail & Remon. tag in NE side power pole N45°W 87.06'

Signed by Kirk L. Van Order
 Surveyor's Michigan License No. 23520

Date 12-31-96

11573 0005 PAGE 392

COPY

Section A (continued from Page 2)

A-1

Heath Twp., T.3N., R.14W.

- (16) Kirk L. Van Order survey dated June 7, 1994
Fd. iron bar in mon. box Same ties as in (11)
Angle of 89°-32'-56" at the NW corner of Sec. 6, T.3N., R.14W.
- (17) Kirk L. Van Order survey dated April 11, 1989
Fd. iron in mon. box
Power pole NE 79.90'
Tele. pole SE 45.65'
Sup. pole SW 44.12'