

RF

MAR 07 2000

ALLEGAN COUNTY REMONUMENTATION  
LAND CORNER RECORDATION CERTIFICATE  
Filing Requirement of Act 74, Mich. P.A. 1970

SECTION

For corners in  
Allegan \_\_\_\_\_  
(County)

Located In: Corner Code #

1. Public Land Survey T4N R16W G-12  
T R  
T R East 1/4 corner  
T R Section 34  
2. Property Controlling S T R Laketown Twp.  
in Section S T R  
3. Miscellaneous S T R  
Property in Sec. S T R

REGISTER OF DEEDS  
ALLEGAN COUNTY, MICH.

00 FEB - 1 AM 8:41

FILED

Register of Deeds Stamp & File Number

4. Lot No. \_\_\_\_\_, Recorded Plat \_\_\_\_\_
5. Private Claims \_\_\_\_\_

	A	B	C	D	E	F	G	H	I	J	K	L	M
1													
2	6	5	4	3	2	1							
3													
4	7	8	9	10	11	12							
5													
6	18	17	16	15	14	13							
7													
8	19	20	21	22	23	24							
9													
10	30	29	28	27	26	25							
11													
12	31	32	33	34	35	36							
13													

I, Steve Lampen \_\_\_\_\_, in a field survey on January 25, 1999, do hereby certify that under requirements of P.A. 74, Michigan P.A. of 1970, the corner points mentioned in lines 1 and 2 above were in conformance with regulations and rules therefore as required in the current manual of survey instructions of the United States Department of the Interior, Bureau of Land Management or by a decree of a Court of Law and/or that the corner points mentioned in lines 3, 4 and 5 above were in conformance with the rules of the Michigan Board of Land Surveyors or by a Decree of a Court of Law; established, re-established, monumented, re-monumented, recovered, found as expressed below:

NOTE: Not more than 4 corners, all in the same town and range, may be recorded on this certificate.

A. Description of original monument and accessories and/or subsequent restoration:

G-12 Old Record by W & W  
GLO - Brookfield - 1831 G-12 to G-13 = 2660  
Set 1/4 section post  
Beech 18 N 54 W 14  
Hemlock 20 S 66 E 37

Survey recorded in L918, Page 729  
Ratekin - 1977  
G-11 to E 1/8 post, NE 1/4, Section 33  
= 1311.11

B. Description of corner evidence found and/or method applied in restoring or reestablishing corner:

G-12 Found pipe iron at the East 1/8 corner, NE 1/4 Section 33, 1311.03' South of G-11 and extended it South 1311.03' to set G-12.

Found capped iron - B. Jones within 0.5 feet G-12 to G-13 rec. = 2660 measure = 2659.44  
G-12 is 3.34 feet East of G-11 to G-13

Set an Allegan County Remonumentation iron and cap and accepted it as a careful re-establishment of the position of the original corner.

Traversed 5281' off road.


G-12 was approved by the Allegan County Remonumentation Peer Group on November 9, 1999

APPROVED REMONUMENTATION CORNER  
P.A. 345 OF 1990  
ALLEGAN COUNTY  
DATE APPROVED NOV. 9, 1999  
COUNTY REP [Signature]

C. Description of monument for corner and accessories established to perpetuate locating the position of the corner:

G-12 Allegan County Remonumentation iron and cap.  
Azimuth = Michigan State Plane grid direction

Remonumentation tag in West side 20" Oak	313° 04'	23.44
Remonumentation tag in NW side 16" Maple	210° 20'	16.99
Remonumentation tag in South side 20" Oak	51° 20'	33.90
Remonumentation tag in West side 12" Oak	352° 24'	40.76

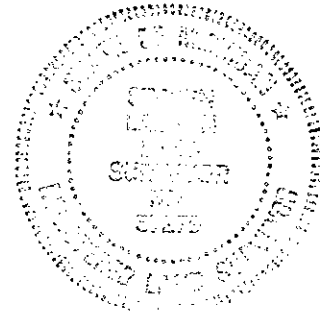

Signed by Steve Lampen Date DECEMBER 31, 1999

Surveyor's Michigan License No. 37279