

**SURVEY
REMONUMENTATION**

APR 29 1999

SECTION

**ALLEGAN COUNTY REMONUMENTATION
LAND CORNER RECORDATION CERTIFICATE
Filing Requirement of Act 74, Mich. P.A. 1970**

For corners in <u>Allegan</u> (County)	Located In:	Corner Code #
1. Public Land Survey	T4N ___ R16W ___	J-13
	T ___ R ___	_____
	T ___ R ___	South 1/4 corner
	T ___ R ___	Section 35 Laketown
2. Property Controlling in Section	S ___ T ___ R ___	Township
	S ___ T ___ R ___	_____
3. Miscellaneous Property in Sec.	S ___ T ___ R ___	_____
	S ___ T ___ R ___	_____

FILED
1/28/1999 2:44:39 PM

JOYCE A. WATTS
REGISTER OF DEEDS
ALLEGAN COUNTY, MICH

Register of Deeds Stamp & File Number

LIBER 006 PAGE 56

4. Lot No. _____, Recorded Plat _____
5. Private Claims _____

I, Steve Lampen, in a field survey on December 4, 1998, do hereby certify that under requirements of P.A. 74, Michigan P.A. of 1970, the corner points mentioned in lines 1 and 2 above were in conformance with regulations and rules therefore as required in the current manual of survey instructions of the United States Department of the Interior, Bureau of Land Management or by a decree of a Court of Law and/or that the corner points mentioned in lines 3, 4 and 5 above were in conformance with the rules of the Michigan Board of Land Surveyors or by a Decree of a Court of Law; established, re-established, monumented, re-monumented, recovered, found as expressed below:

NOTE: Not more than 4 corners, all in the same town and range, may be recorded on this certificate.

A. Description of original monument and accessories and/or subsequent restoration:

J-13	MSH-1960 -	L.C.R.C. - L1, P312 - Ratekin - 1972
GLO-Lyon-Sibley	Found stone raised with 3/4" pipe	Found 3/4" pipe
Set H.M.P.	West to N 1/4 Sec. 2 Saugatuck 3.51	N 1/4 post Sec. 2, T3N, R16W, W 3.51
Hemlock 5 N64 E 10		
Hemlock 18 N 51 W 11		
1907 - MacDougal		
Found stone		
Stone West 3.5'		

B. Description of corner evidence found and/or method applied in restoring or reestablishing corner:

J-13 Found 3/4" pipe in monument box West to N 1/4 Section 2, Saugatuck 3.51
J-13 to I-13 rec.= 2649.5 measured 2648 J-13 to K-13 rec.= 2646 measured = 2643.56

Replaced 3/4" pipe with 3/4"x24" Allegan County Remonumentation iron and cap and accepted it as a careful and faithful perpetuation of the position of the original corner.


This corner was accepted by the Allegan County Remonumentation Peer Group on December 8, 1998.

APPROVED REMONUMENTATION CORNER
P.A. 345 OF 1990
ALLEGAN COUNTY
DATE APPROVED DEC. 8, 1998
COUNTY REP. [Signature]

C. Description of monument for corner and accessories established to perpetuate locating the position of the corner:

J-13 3/4"x24" Allegan County Remonumentation iron and cap in monument box.
Azimuth=Michigan State Plane grid direction

SW corner house foundation	331° 44'	168.72
Power pole, remonumentation tag in E side	195° 26'	127.99
Guy pole, remonumentation tag in W side	170° 29'	156.35
Power pole, remonumentation tag in S side	79° 42'	189.74
Power pole, remonumentation tag in SW side	322° 42'	45.55
J-1, Town 3 North, Range 16 West	270° 55'	3.51

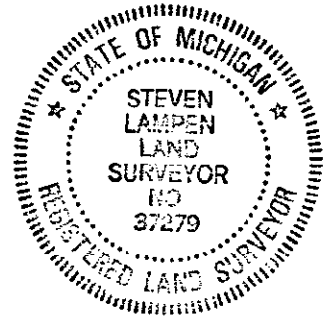

Signed by Steven Lampen Date JANUARY 11, 1999

Surveyor's Michigan License No. 37279