

APR 29 1999

SECTION

Allegan County Remonumentation
LAND CORNER RECORDATION CERTIFICATE
Filing Requirement of Act 74, Mich. P.A. 1970

LIBERO 006 PAGE 57

For corners in Allegan (County)	Located In:	Corner Code #
1. Public Land Survey	T4N R16W	K-13 (SE cor. Sec. 35) Laketown Twp.
	T R	
	T R	
	T R	
2. Property Controlling in Section	S T R	
	S T R	
3. Miscellaneous Property in Sec.	S T R	
	S T R	

FILED
1/28/1999 2:44:39 PM
JOYCE A. WATTS
REGISTER OF DEEDS
ALLEGAN COUNTY, MICH
Register of Deeds Stamp & File Number

- 4. Lot No. _____, Recorded Plat _____
- 5. Private Claims _____

1	A	B	C	D	E	F	G	H	I	J	K	L	M
2	6	5	4	3	2	1							
3													
4	7	8	9	10	11	12							
5													
6	18	17	16	15	14	13							
7													
8	19	20	21	22	23	24							
9													
10	30	29	28	27	26	25							
11													
12	31	32	33	34	35	36							
13													

I, Steven Lampen, in a field survey on December 17, 1997, do hereby certify that under requirements of P.A. 74, Michigan P.A. of 1970, the corner points mentioned in lines 1 and 2 above were in conformance with regulations and rules therefore as required in the current manual of survey instructions of the United States Department of the Interior, Bureau of Land Management or by a decree of a Court of Law and/or that the corner points mentioned in lines 3, 4 and 5 above were in conformance with the rules of the Michigan Board of Land Surveyors or by a Decree of a Court of Law; established, re-established, monumented, re-monumented, recovered, found as expressed below:

NOTE: Not more than 4 corners, all in the same town and range, may be recorded on this certificate.

A. Description of original monument and accessories and/or subsequent restoration:

- K-13
GLO
Lyon 1832
80.00' set post Sections 35 and 36
Beech 16" N 31° W 46
Hemlock 7" N 66° E 55
D.A. Ratekin Act 74
L 2 P 241 1973
3/4" Pipe
NE corner Section 2, Saugatuck Twp. E 1.98' 1" iron
NW corner telephone outlet S 20° W 26.76'
Street sign S 25° W 18.18'
E end 48" corrugated metal pipe N 55° W 35.71'
- D.A. Ratekin Survey 1971
Power pole S 30° W 27.0'
10" Maple S 30° E 54.65'
28" Maple N 60° W 98.5'
Kirk VanOrder 1991
Found capped iron in monument box
SW corner porch foundation ENE 190.55', SW corner house foundation ENE 190.72', Power pole NNW 154.61', Centerline buried cable post ESE 98.95'

B. Description of corner evidence found and/or method applied in restoring or reestablishing corner:

- K-13
Found capped "T" iron in monument box
NE corner Section 2, T3N, R16W, E 1.98'
Power pole NNW 154.56'
"X" S end concrete culvert SE 101.12'
SW corner concrete block house (not porch) ENE 190.74'
SW corner porch foundation 190.55'
Centerline buried cable post ESE 98.95'
The "T" Iron is accepted as a careful and faithful re-establishment of the original corner.

Replaced "T" iron with 3/4"x24" Allegan County Remonumentation iron and Remonumentation cap


This corner approved by the Allegan County Surveyors Peer Group on February 11, 1997.

APPROVED REMONUMENTATION CORNER
P.A. 345 OF 1990
ALLEGAN COUNTY
DATE APPROVED FEB. 11, 1997
COUNTY REP. [Signature]

C. Description of monument for corner and accessories established to perpetuate locating the position of the corner:

K-13
3/4"x24" Allegan County Remonumentation iron and cap in monument box.

- Power pole Remon. tag E side 346° 154.54'
- SW corner brick foundation (not porch) 69° 190.64'
- "X" in end 24" concrete culvert 322° 56.24'
- "X" in end 24" concrete culvert 117° 101.19'
- K-1, T3N, R16W 91° 07' 1.98'

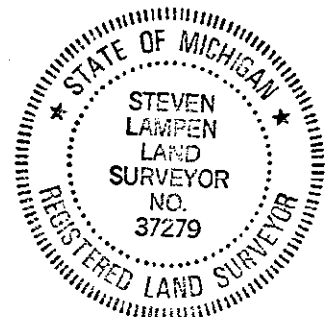

Signed by Steven Lampen

Date February 12, 1997

Surveyor's Michigan License No. 37279