

QUALITY & RELIABILITY

MAR 07 2000

ALLEGAN COUNTY REMONUMENTATION LAND CORNER RECORDATION CERTIFICATE Filing Requirement of Act 74, Mich. P.A. 1970

REGISTER OF DEEDS ALLEGAN COUNTY

00 FEB - 1 AM 8:41

FILED

BOOK 00 / PAGE 323

SECTION For corners in Allegan (County)

Located In: Corner Code #

- 1. Public Land Survey T4N R16W M-11 T R T R NE corner T R Section 36 2. Property Controlling in Section S T R S T R Laketown Twp. 3. Miscellaneous Property in Sec. S T R S T R

Register of Deeds Stamp & File Number

- 4. Lot No. Recorded Plat 5. Private Claims

I, Steve Lampen, in a field survey on December 13, 1999, do hereby certify that under requirements of P.A. 74, Michigan P.A. of 1970, the corner points mentioned in lines 1 and 2 above were in conformance with regulations and rules therefore as required in the current manual of survey instructions of the United States Department of the Interior, Bureau of Land Management or by a decree of a Court of Law and/or that the corner points mentioned in lines 3, 4 and 5 above were in conformance with the rules of the Michigan Board of Land Surveyors or by a Decree of a Court of Law; established, re-established, monumented, re-monumented, recovered, found as expressed below:

Grid table with columns A-M and rows 1-13. Contains numbers 6 through 36.

NOTE: Not more than 4 corners, all in the same town and range, may be recorded on this certificate.

A. Description of original monument and accessories and/or subsequent restoration:

- M-11 1831 GLO - L. Lyon - set post Hemlock 30 S 15 W 20 Hemlock 28 N 56 W 28 Found iron PK nail in Telephone pole SW 47.38' Nail in telephone pole NW 80.50' PK nail in Power pole NE 55.50' Nail in telephone pole SE 57.34' Iron S 6.6' 1972 D. Ratekin - L.C.R.C., L1, P307 Set 3/4" iron shaft by extending from SE corner over NW corner Sec. 31, Fillmore for 6.6' (Gov't jog distance) Telephone pole S 45 W 47.6' Centerline telephone box S 60 W 85.2' Power pole S 30 E 57.45' "T" iron S 6.60' 1975 - D. Greer, L.C.R.C., L2, P387 Found 3/4" steel rod "T" iron S 6.60' Power pole N 70 E 55.48' Power pole S 30 E 57.33' Telephone pole S 40 W 47.35' Power pole N 40 W 80.42'

B. Description of corner evidence found and/or method applied in restoring or reestablishing corner:

- M-11 Found 3/4" iron in monument box Telephone pole S 45 W 47.6' Power pole S 30 E 57.45' Remonumentation iron S 6.60 Nail in Telephone pole SW 47.38' Nail in Telephone pole SE 57.34' Power pole S 30 E 57.33'


Replaced iron with an Allegan County Remonumentation iron and cap and accepted it as a careful and Faithful perpetuation of the position of the original corner.

Approved by the Allegan County Remonumentation Peer Group on December 14, 1999

APPROVED REMONUMENTATION CORNER P.A. 345 OF 1990 ALLEGAN COUNTY DATE APPROVED DEC. 14, 1999 COUNTY REP. [Signature]

C. Description of monument for corner and accessories established to perpetuate locating the position of the corner:

- M-11 Allegan County Remonumentation iron and cap in monument box. Azimuth = Michigan State Plane grid direction Remonumentation tag in S side Power pole 301° 23' 81.14 Remonumentation tag in NW side Power pole 31° 54' 139.86 Remonumentation tag in SW side Power pole 148° 44' 57.83 A-11, T3N, R15W 180° 13' 6.65

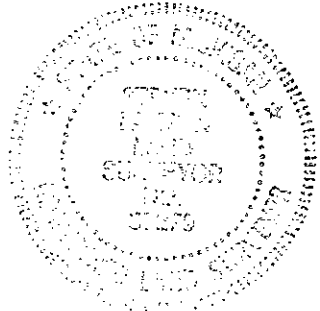

Signed by Steven Lampen

Date DECEMBER 31, 1999

Surveyor's Michigan License No. 37279