

**SURVEY &
REMONUMENTATION**

MAR 07 2000

SECTION

**ALLEGAN COUNTY REMONUMENTATION
LAND CORNER RECORDATION CERTIFICATE
Filing Requirement of Act 74, Mich. P.A. 1970**

REGISTER OF DEEDS
ALLEGAN COUNTY MI
Joyce A. Clavin

00 FEB -1 AM 8:41

LIBER 005-1446321

For corners in
Allegan
(County)

Located In: Corner Code #

1. Public Land Survey T4N R16W M-12
T R
T R
T R
East 1/4 corner
Section 36
Laketown Twp.

2. Property Controlling S T R
in Section S T R
Miscellaneous S T R
3. Property in Sec. S T R

4. Lot No. _____, Recorded Plat _____

5. Private Claims _____

Register of Deeds Stamp & File Number

	A	B	C	D	E	F	G	H	I	J	K	L	M
1													
2	6		5		4		3		2		1		
3													
4	7		8		9		10		11		12		
5													
6	18		17		16		15		14		13		
7													
8	19		20		21		22		23		24		
9													
10	30		29		28		27		26		25		
11													
12	31		32		33		34		35		36		
13													

I, Steve Lampen, in a field survey on December 13, 1999, do hereby certify that under requirements of P.A. 74, Michigan P.A. of 1970, the corner points mentioned in lines 1 and 2 above were in conformance with regulations and rules therefore as required in the current manual of survey instructions of the United States Department of the Interior, Bureau of Land Management or by a decree of a Court of Law and/or that the corner points mentioned in lines 3, 4 and 5 above were in conformance with the rules of the Michigan Board of Land Surveyors or by a Decree of a Court of Law; established, re-established, monumented, re-monumented, recovered, found as expressed below:

NOTE: Not more than 4 corners, all in the same town and range, may be recorded on this certificate.

A. Description of original monument and accessories and/or subsequent restoration:

M-12
1831 - L. Lyon - set post
Lynn 34 N 61 W 12
Beech 12 S 4 W 11

1975 D. Greer - L.C.R.C., L2, P387
Found 1" iron in centerline of pavement midway on line between M-11 and M-13
Power pole W 129.85'
Centerline top S end CMP E 25.15'
Centerline top N end CMP N 45 E 35.00'

B. Description of corner evidence found and/or method applied in restoring or reestablishing corner:

M-12 Found 3/4" pipe in monument box Power pole W 129.85' Centerline top S end CMP E 25.15'
Centerline top N end CMP N 45 E 35.00'

Replaced pipe with an Allegan County Remonumentation iron and cap and accepted it as a careful and faithful perpetuation of the position of the original corner.

Approved by the Allegan County Remonumentation Peer Group on December 14, 1999

APPROVED REMONUMENTATION CORNER


P.A. 345 OF 1990
ALLEGAN COUNTY

DATE APPROVED DEC 14, 1999
COUNTY REP. [Signature]

C. Description of monument for corner and accessories established to perpetuate locating the position of the corner:

M-12 Allegan County Remonumentation iron and cap in monument box.
Azimuth = Michigan State Plane grid direction

Remonumentation tag in E side Power pole	335° 25'	225.15
Remonumentation tag in S side Power pole	269° 22'	130.39
Remonumentation tag in E side Power pole	206° 06'	293.82
Centerline N and S asphalt road pavement	90°	1'
A-12, T4N, R15W	180° 12' 30"	4.62

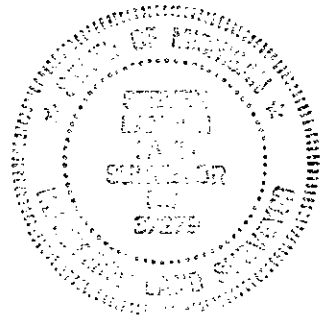

Signed by Steve Lampen

Date DECEMBER 31, 1999

Surveyor's Michigan License No. 37279