

**1999 Alpena County Remonumentation Corner
LAND CORNER RECORDATION CERTIFICATE
Filing Requirement of Act 74, Mich. P.A. 1970**

RECORDED

For corners in

JAN 21 2000

Alpena Located In: Corner Code #
(County)

1. Public Land Survey T 29N R 5E L-3
T R
T R
T R

2. Property Controlling S T R
in Section S T R

3. Miscellaneous S T R
Property in Sec. S T R

SECTION



L-2 P-274
12/10/1999 01:39P
Page: 1 of 1
Kathy J. Matash, Register Alpena Co., MI LDC 9.00

Register of Deeds Stamp & File Number

4. Lot No. _____, Recorded Plat _____
5. Private Claims _____

I, Daniel T. Kibbe, in a field survey on June 2, 1999 do hereby state that under requirements of P.A. 74, Michigan P.A. of 1970, the corner points mentioned in lines 1 and 2 above were in conformance with regulations and rules therefore as required in the current manual of survey instructions of the United States Department of the Interior, Bureau of Land Management or by a decree of a Court of Law and /or that the corner points mentioned in lines 3, 4 and 5 above were in conformance with the rules of the Michigan Board of Land Surveyors or by a Decree of a Court of Law; established, re-established, monumented, recovered, found as expressed below:

	A	B	C	D	E	F	G	H	I	J	K	L	M
1													
2	6			5			4		3			2	1
3													
4	7			8			9		10			11	12
5													
6	18			17			16		15			14	13
7													
8	19			20			21		22			23	24
9													
10	30			29			28		27			26	25
11													
12	31			32			33		34			35	36
13													

NOTE: Not more than 2 corners, all in the same town and range, may be recorded on this certificate

A. Description of original monument and accessories and/or subsequent restoration:

- 1839: GLO Survey by Lewis Clason. Set 1/4 post. Referenced: W. Pine 7-N28E-9/Y. Pine 6-S46W-10.
- 1912: County Survey by Jos. W. McNeil. Everything burnt and gone, no trace of 1/4 corner. Set 1/4 post 1 & 12, no trees near for NWT. Survey Witnesses by Gary St. Charles. Ex 3/8" rerod. Referenced: 1x4 & nail-N04E-33.00'/1x4 & nail-S46E-53.80'/Power Pole-S31W-36.75'.

B. Description of corner evidence found and/or method applied in restoring or reestablishing corner:


- 1999: Remon. Survey by Daniel T. Kibbe. 3/8" Iron in Mon. Box in CL Road.
This corner position is compatible with county & local surveys. This corner position is accepted as a careful and faithful perpetuation of the position of the original corner.

C. Description of monument for corner and accessories established to perpetuate locating the position of the corner:

- 1999: Placed 3" Alpena County cap stamped to identify the corner over 1/2" iron rod in monument box.
Referenced:
P. Pole-set tag-S20 W 36.72'
Large Fence Post-set tag S68 E 191.45'
P. Pole-set tag-N73 W 149.13'
Set PK Nail C/L Road East 50.00'
Set PK Nail C/L Road West 50.00'

P.A. 345 ALPENA COUNTY
PEER APPROVED 9/16/99
D.T. Kibbe

Signed by *Daniel T. Kibbe*
Surveyor's Michigan License No. 37278

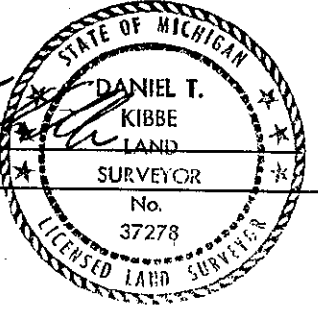

Date November 30, 1999