LAND CORNER RECORDATION CERTIFICATE Filing Requirement of Act 74, Mich. P.A. 1970

For corners in Alpena (County)	Located In:	Corner Code ##
1. Public Land Survey	T R T R T R	
Property Controlling in Section Miscellaneous	S 17 T 29N R 6E S 17 T 29N R 6E S 17 T 29N R 6E S 17 T 29N R 6E	8 11 12


Property in Sec.


Register of Deeds Stamp & File Number

Recorded Plat 4. Lot No. 5. Private Claims .

May 8, I, Carl R. Johnson , in a field survey on _ do hereby certify that under requirements of P.A. 74, Michigan P.A. of 1970, the corner points mentioned in lines 1 and 2 above were in conformance with regulations and rules therefore as required in the current manual of survey instructions of the United States Department of the Interior, Bureau of Land Management or by a decree of a Court of Law and/or that the corner points mentioned in lines 3, 4 and 5 above were in conformance with the rules of the Michigan Board of Land Surveyors or by a Decree of a Court of Law; established, re-established, monumented, re-monumented, recovered, found as expressed below:

NOTE: Not more than 4 corners, all in the same town and range, may be recorded on this certificate.

 

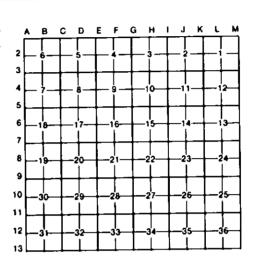

- B. Description of corner evidence found and/or method applied in restoring or reestablishing corner:
- 8 Set by standard survey procedure for subdivision of a section.
- 11 Set by standard survey procedure for subdivision of a section.
- 12 Set by standard survey procedure for subdivision of a section.
- C. Description of monument for corner and accessories established to perpetuate locating the position of the corner:

11 - Center SW4 12 - S1/8 N-S 1 line 8 - W1/8, E-W \(\frac{1}{4} \) Line 5/8" bar w/cap 6" Maple N32 E 11.7' 6" Maple S32 W 19.3' 5" Maple N44 W 29.1' 5/8" bar w/cap 2" Pipe S84 W 4" Ash S49 E 5/8" bar w/cap 5" Maple S62 E 38.9' 4" Maple S89 W 14.2' 6" Maple N13 E 23.0' 36.91 6.81

CARL R ALIMIN LAND

Signed by

Surveyor's Michigan License No. ___ 30083 Date _

FORM APPROVED BY MICHIGAN STATE BOARD OF LAND SURVEYORS, JAN. 28, 1971 REVISED MAY 14, 1975