

**1999 Alpena County Remonumentation Corner
LAND CORNER RECORDATION CERTIFICATE
Filing Requirement of Act 74, Mich. P.A. 1970**

REMONUMENTATION

JAN 21 2000

For corners in

<u>Alpena</u> (County)	Located In:	Corner Code #
1. Public Land Survey	T. <u>29N</u> R <u>5E</u>	<u>M-7</u>
	T. <u>29N</u> R <u>6E</u>	<u>A-7</u>
	T. <u> </u> R. <u> </u>	—
	T. <u> </u> R. <u> </u>	—
2. Property Controlling in Section	S. <u> </u> T. <u> </u> R. <u> </u>	—
	S. <u> </u> T. <u> </u> R. <u> </u>	—
3. Miscellaneous Property in Sec.	S. <u> </u> T. <u> </u> R. <u> </u>	—
	S. <u> </u> T. <u> </u> R. <u> </u>	—

SECTION

L- 2 P- 272
12/10/1999 01:39P
Page: 1 of 1
Kathy J. Matash, Register Alpena Co., MI LDC 9.00

Register of Deeds Stamp & File Number

4. Lot No. _____, Recorded Plat _____
5. Private Claims _____

	A	B	C	D	E	F	G	H	I	J	K	L	M
1													
2	6		5		4		3		2		1		
3													
4	7		8		9		10		11		12		
5													
6	18		17		16		15		14		13		
7													
8	19		20		21		22		23		24		
9													
10	30		29		28		27		26		25		
11													
12	31		32		33		34		35		36		
13													

I, Daniel T. Kibbe, in a field survey on June 14, 1999 do hereby state that under requirements of P.A. 74, Michigan P.A. of 1970, the corner points mentioned in lines 1 and 2 above were in conformance with regulations and rules therefore as required in the current manual of survey instructions of the United States Department of the Interior, Bureau of Land Management or by a decree of a Court of Law and /or that the corner points mentioned in lines 3, 4 and 5 above were in conformance with the rules of the Michigan Board of Land Surveyors or by a Decree of a Court of Law; established, re-established, monumented, recovered, found as expressed below:

NOTE: Not more than 2 corners, all in the same town and range, may be recorded on this certificate

A. Description of original monument and accessories and/or subsequent restoration:

- 1839: GLO Survey by Lewis Clason. Set post corner Sec. 13 & 24. Referenced W. Oak 6-S32W-29/Y. Pine 18-N22W-63.
- 1908: County Survey by Jos. W. McNeil. Found part of both OBT's, set large cedar stake, no timber near for N.W.T. Referenced: Y. Pine 18-N39W-63 (down and partly burnt)/W. Oak 6-S23W-29 (badly rotted).
- 1932: County Survey by Wm. H. LeRoy. Replaced old corner with concrete 6"x6"x36".
- 1959: MDOT Road Plans by N. C. Caldwell. Found 3/4" pipe. Referenced: Chiseled "X" in ring-N73E-63.35'/Chiseled "X" in ring-N75W-61.82'.
- 1959: MDOT Survey by N.C. Caldwell. Found 1/2" bar in 6"x6" conc. mon. 0.61' Lt. Sta 280+05.07. Referenced: 12" Oak-N55E-204.00'/10" W. Birch-N30E-200.38'/Power Pole-S45E-133.10'.
- 1959: MDOT Recorded Corner by N.C. Caldwell. Found 1/2" bar in 6"x6" conc. mon. 0.61' Lt. Sta 280+05.07. Referenced: 12" Oak-N55E-204.00', 10" W. Birch-N30E-200.38'/Power Pole-S45E-133.10'.
- 1962: Witness Records by Porter Survey. 1 1/4" Pipe in mon. box 0.61' Lt. Of C/L of HWY M-65. Gerald Wozniak-MSHD. Referenced: Chiseled "X" in ring-N73E-63.35'/Chiseled "X" in culv. ring-N75W-61.82'/P. Pole-S45E-133.40'
- 1993: MDOT Recorded Corner by Cliff Lindgren. Found 1 1/4" pipe in mon. box, 0.61' west of M-65 CL. Referenced: Exist MSHD tag in P. Pole-S40E-133.22'/Chiseled "x" N. end concrete culv.-N80E-63.42'/Center road sign post-N50W-52.44'/Chiseled "x" S. end concrete culv.-S75W-62.62'.
- 1993: Recorded Corner by Cliff Lindgren. Found 1 1/4" pipe in mon. box, 0.61' west of M-65 CL. Referenced: Exist MSHD tag in P. Pole-S40E-133.22'/Chiseled "x" N. end con. culv. N80E-63.42'/Center road sign post-N50W-52.44'/Chiseled "x" S. end concrete culvert-S75W-62.62'.
- 1998: Recorded Corner by Joseph C. Kapelczak. Found 1 1/4" pipe in mon. box, 0.61' west of CL of M-65, as recorded in LCRC L 1-P290, Alpena County Records. Referenced: Exist MSHD tag in P. Pole-S40E-133.22'/Chiseled "x" N. end concrete culvert-N80E-63.42'/Center road sign post-N50W-52.44'/Chiseled "X" S. end concrete culv.-S75W-62.62'.
- 1998: Certificate of Survey by Joseph C. Kapelczak. Referenced corner, see above recorded corner.

B. Description of corner evidence found and/or method applied in restoring or reestablishing corner:

- 1999: Remon. Survey by Daniel T. Kibbe. Found 1 1/4" pipe in mon. box 0.5' West of CL M-65, 2' North CL roads East & West.


This corner position is compatible with county & local surveys. This corner position is accepted as a careful and faithful perpetuation of the position of the original corner.

C. Description of monument for corner and accessories established to perpetuate locating the position of the corner:

- 1999: Placed 3" Alpena County cap stamped to identify the corner over 1/2" iron rod in 1 1/4" pipe in monument box.
Referenced:
Fence Post-set tag-N05 W 211.89'
P. Pole-set tag-N20 E 256.24'
P. Pole-found tag MSHD-S40 E 133.22'
36" Oak-set tag-N82 E 178.10'

P.A. 345 ALPENA COUNTY
PEER APPROVED 9/16/99
D. B. [Signature]

Signed by [Signature]
Surveyor's Michigan License No. 37278

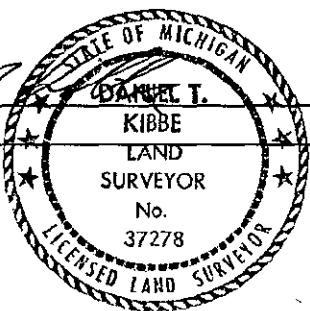

Date November 30 1999