

1995 Alpena County Remonumentation Corner

LAND CORNER RECORDATION CERTIFICATE
Filing Requirement of Act 74, Mich. P.A. 1970

JUL 31 9 59 AM '95

Maureen A. Johnston
REGISTER OF DEEDS

For corners in

<u>Alpena</u> (County)	Located In:	Corner Code #
1. Public Land Survey	T <u>29N</u> R <u>6E</u>	<u>A-10</u>
	T _____ R _____	_____
	T _____ R _____	_____
	T _____ R _____	_____
2. Property Controlling in Section	S _____ T _____ R _____	_____
	S _____ T _____ R _____	_____
3. Miscellaneous Property in Sec.	S _____ T _____ R _____	_____
	S _____ T _____ R _____	_____

Register of Deeds Stamp & File Number

- 4. Lot No. _____, Recorded Plat _____
- 5. Private Claims _____

I, Daniel T. Kibbe, in a field survey on May 15, 19 95, do hereby certify that under requirements of P.A. 74, Michigan P.A. of 1970, the corner points mentioned in lines 1 and 2 above were in conformance with regulations and rules therefore as required in the current manual of survey instructions of the United States Department of the Interior, Bureau of Land Management or by a decree of a Court of Law and/or that the corner points mentioned in lines 3, 4 and 5 above were in conformance with the rules of the Michigan Board of Land Surveyors or by a Decree of a Court of Law; established, re-established, monumented, re-monumented, recovered, found as expressed below:

NOTE: Not more than 4 corners, all in the same town and range, may be recorded on this certificate.

	A	B	C	D	E	F	G	H	I	J	K	L	M
2	6	5	4	3	2	1							
3													
4	7	8	9	10	11	12							
5													
6	18	17	16	15	14	13							
7													
8	19	20	21	22	23	24							
9													
10	30	29	28	27	26	25							
11													
12	31	32	33	34	35	36							
13													

- A. Description of original monument and accessories and/or subsequent restoration:
- 1839: G.L.O. Survey by Thomas Pattison - set quarter section post & referenced: Hd. Maple 10 - S 69 W - 29 / Y. Pine 18 - N 55 W - 44.
 - 1914: County Survey by Jos. W. McNeil - no old marks, set corner & referenced.
 - 1959: Monument Witness Record by N.C.C. Survey Chief - found 3/4" pipe & referenced. MSHD Highway Plans - referenced.
 - 1962: Monument Witness Record by Gerald Wozniak - 1 1/4" pipe in mon. box & referenced. MSHD - Updated witnesses.
 - 1973, 82: Surveys by James Scott and Duane MacNeill - found monument box.
 - 1993: Survey by Earl Lewis - found monument box & referenced.
 - 1993: LCRC & Monument Witness Record by Clifford Lindgren, MDOT-found 1 1/4" pipe in mon. box & referenced.
- B. Description of corner evidence found and/or method applied in restoring or reestablishing corner:
- 1995: Found 1 1/4" pipe in monument box, 4.5' West of M-65 C/L.

This corner position is compatible with county and local surveys and agrees with MDOT records. This corner position is accepted as a careful and faithful perpetuation of the position of the original corner.

SURVEY &
REMONUMENTATION


AUG 28 1995

COMMISSION

P.A. 345 ALPENA COUNTY
PEER APPROVED 6/6/95
D.P. Allen

C. Description of monument for corner and accessories established to perpetuate locating the position of the corner:

- 1995: Placed 3" aluminum cap stamped to identify the corner on 1/2" iron rod over existing 1 1/4" pipe in monument box.
- Referenced:
- S 83° E - 96.07' - N/Tag in 14" Poplar
 - S 36° E - 119.48' - N/Tag in 4" Poplar
 - N 64° W - 77.39' - N/Tag in Power Pole
 - S 73° W - 62.92' - N/Tag in 8" Poplar

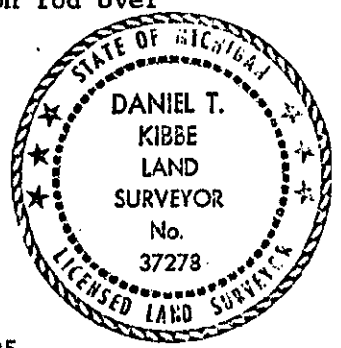

Signed by *Daniel T. Kibbe* Date July 24, 1995
 Surveyor's Michigan License No. 37278