

1995 Alpena County Remonumentation Corner

LAND CORNER RECORDATION CERTIFICATE Filing Requirement of Act 74, Mich. P.A. 1970

JUL 31 9 59 AM '95

REGISTER OF DEEDS

For corners in

Alpena (County)	Located In:	Corner Code #
1. Public Land Survey	T 29N R 6E	C-9
	T ___ R ___	_____
	T ___ R ___	_____
	T ___ R ___	_____
2. Property Controlling in Section	S ___ T ___ R ___	_____
	S ___ T ___ R ___	_____
3. Miscellaneous Property in Sec.	S ___ T ___ R ___	_____
	S ___ T ___ R ___	_____

Register of Deeds Stamp & File Number

- 4. Lot No. _____, Recorded Plat _____
- 5. Private Claims _____

A	B	C	D	E	F	G	H	I	J	K	L
2	6	5	4	3	2	1					
3											
4	7	8	9	10	11	12					
5											
6	15	17	16	15	14	13					
7											
8	19	20	21	22	23	24					
9											
10	30	29	28	27	26	25					
11											
12	31	32	33	34	35	36					

I, Daniel T. Kibbe, in a field survey on June 15, 1995, do hereby certify that under requirements of P.A. 74, Michigan P.A. of 1970, the corner points mentioned in lines 1 and 2 above were in conformance with regulations and rules therefore as required in the current manual of survey instructions of the United States Department of the Interior, Bureau of Land Management or by a decree of a Court of Law and/or that the corner points mentioned in lines 3, 4 and 5 above were in conformance with the rules of the Michigan Board of Land Surveyors or by a Decree of a Court of Law; established, re-established, monumented, re-monumented, recovered, found as expressed below:

NOTE: Not more than 4 corners, all in the same town and range, may be recorded on this certificate.

A. Description of original monument and accessories and/or subsequent restoration:
 1839: G.L.O. Survey by Thomas Pattison - set post corner & referenced: Y. Pine 24 - N 26 W - 7
 Y. Pine 20 - S 65 E -
 1927: County Survey by Jos. W. McNeil - visited.

B. Description of corner evidence found and/or method applied in restoring or reestablishing corner:
 1995: No monumentation found. Corner position based on proportionate measurements and existing lines of occupation. Corner is 5' S. of physical C/L McDonald Road, 2' E. of fence line to North, C/L trail to South, and at a split of the R.O.W. fences.


This corner is accepted as a careful and faithful perpetuation of the position of the original corner.

SURVEY & REMONUMENTATION
 AUG 23 1995
 COMMISSION

P.A. 345 ALPENA COUNTY
 PEER APPROVED 6/6/95
 [Signature]

C. Description of monument for corner and accessories established to perpetuate locating the position of the corner:

1995: Set 18"x 1/2" iron rod with 3" aluminum cap stamped to identify the corner.
 Referenced:
 S 40° E - 57.44' - set N/Tag in 14" Ash
 S 18° E - 47.90' - set N/Tag in 11" W. Pine
 S 53° W - 52.77' - set N/Tag in 17" R. Pine
 N 42° W - 42.45' - set N/Tag in Power Pole

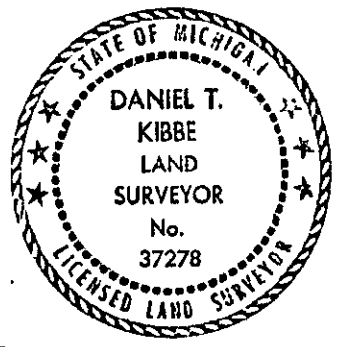

Signed by [Signature] Date July 24, 1995
 Surveyor's Michigan License No. 37278