

1995 ALPENA COUNTY REMONUMENTATION CORNER

003136

RECORDED ALPENA COUNTY MI.

LAND CORNER RECORDATION CERTIFICATE  
Filing Requirement of Act 74, Mich. P.A. 1970

JUN 16 2 52 PM '95

*Spaidys A. Johnston*  
REGISTER OF DEEDS

For corners in

<u>Alpena</u> (County)	Located In:	Corner Code #
1. Public Land Survey	T <u>29N</u> R <u>6E</u>	K-3 (NW, 12). Ossineke Twp.
	T _____ R _____	_____
	T _____ R _____	_____
	T _____ R _____	_____
2. Property Controlling in Section	S _____ T _____ R _____	_____
	S _____ T _____ R _____	_____
3. Miscellaneous Property in Sec.	S _____ T _____ R _____	_____
	S _____ T _____ R _____	_____

Register of Deeds Stamp & File Number

4. Lot No. \_\_\_\_\_, Recorded Plat \_\_\_\_\_  
5. Private Claims \_\_\_\_\_

A	B	C	D	E	F	G	H	I	J	K	L	M
2	6	5	4	3	2	1						
3												
4	7	8	9	10	11	12						
5												
6	13	17	16	15	14	13						
7												
8	19	20	21	22	23	24						
9												
10	30	29	28	27	26	25						
11												
12	31	32	33	34	35	36						
13												

Thomas L. Fabis, in a field survey on March 23, 1995.  
Do hereby certify that under requirements of P.A. 74, Michigan P.A. of 1970, the corner points mentioned in lines 1 and 2 above were in conformance with regulations and rules therefore as required in the current manual of survey instructions of the United States Department of the Interior, Bureau of Land Management or by a decree of a Court of Law and/or that the corner points mentioned in lines 3, 4 and 5 above were in conformance with the rules of the Michigan Board of Land Surveyors or by a Decree of a Court of Law; established, re-established, monumented, re-monumented, recovered, found as expressed below:

NOTE: Not more than 4 corners, all in the same town and range, may be recorded on this certificate.

A. Description of original monument and accessories and/or subsequent restoration:

- 1839: G.L.O. Survey by Lewis Clason - Set post & referenced: (Cedar 13 - N28E - 29, Cedar 9 - S27W - 19).
- 1904: County Survey by Jos. W. McNeill - Set large cedar stake & referenced: (W. Pine stump 30 - S23½E - 176½)

B. Description of corner evidence found and/or method applied in restoring or reestablishing corner:

1995: Found 50 penny nail over another nail at intersection of centerlines of gravel roads. Found roofing nail with flagging in Anchor Pole - N40E - 38.57'. This corner was set and used by other land surveyors. It's position is compatible with the early county surveys and is accepted as a careful and faithful perpetuation of the position of the original corner.

REMONUMENTATION

AUG 23 1995


COMMISSION

C. Description of monument for corner and accessories established to perpetuate locating the position of the corner:

- 1995: Removed existing corner material and set ½" iron rod with 3" dia. aluminum cap, stamped to identify the corner.
- Reestablished witnesses are:
  - Set tag #31591 in Anchor Pole - N40E - 38.57'
  - Set tag #31591 in 3" Balm of Gilead - N45W - 60.16'
  - Set tag #31591 in P. Pole - S45W - 41.92'
  - Set tag #31591 in Fe. Post - S55W - 30.11'

P.A. 345 ALPENA COUNTY  
PEER APPROVED May 18, 1995  
*Del B. [Signature]*

Signed by Thomas L. Fabis Date \_\_\_\_\_  
Surveyor's Michigan License No. 31591

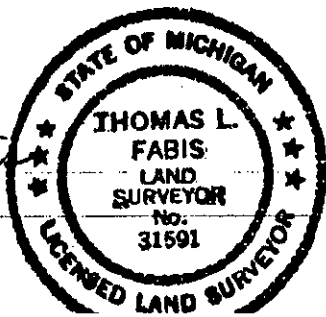

June 12, 1995