

JUN 16 2 52 PM '95

LAND CORNER RECORDATION CERTIFICATE
 Filing Requirement of Act 74, Mich. P.A. 1970

Maning A. Johnston
 REGISTER OF DEEDS

corners in
Alpena
(County)

Located In: Corner Code #

Public Land Survey T 29N R 6E L-3 (N $\frac{1}{2}$, 12)
 T R Ossineke Twp.
 T R
 T R
 T R

Property Controlling S T R
 in Section S T R
 Miscellaneous S T R
 Property in Sec. S T R

Register of Deeds Stamp & File Number

Lot No. _____, Recorded Plat _____
 Private Claims _____

	A	B	C	D	E	F	G	H	I	J	K	L	M
2	6	5	4	3	2	1							
3													
4	7	8	9	10	11	12							
5													
6	18	17	16	15	14	13							
7													
8	19	20	21	22	23	24							
9													
10	30	29	28	27	26	25							
11													
12	31	32	33	34	35	36							
13													

Thomas L. Fabis, in a field survey on March 23, 1995,
 hereby certify that under requirements of P.A. 74, Michigan P.A. of 1970, the corner points mentioned
 in lines 1 and 2 above were in conformance with regulations and rules therefore as required in the
 current manual of survey instructions of the United States Department of the Interior, Bureau of Land
 Management or by a decree of a Court of Law and/or that the corner points mentioned in lines 3, 4 and 5
 above were in conformance with the rules of the Michigan Board of Land Surveyors or by a Decree of a
 Court of Law; established, re-established, monumented, re-monumented, recovered, found as
 expressed below:

**NOTE: Not more than 4 corners, all in the same town and range, may be recorded
 on this certificate.**

Description of original monument and accessories and/or subsequent restoration:

- 1839: G.L.O. Survey by Lewis Clason - Set post & referenced: (Cedar 13-
 S59W - 20, Hem 6 - N17E - 23).
- 1904: County Survey by Jos. W. McNeil - Set stake & referenced: (W. Pine stub 22 -
 N48E - 124).
- 1978: Recorded Survey by David B. Guthrie - Set 1/2" iron at inters. road & fences
 & referenced.

1991: Survey by Earl T. Lewis - Found 1/2" iron rod & referenced.
 Description of corner evidence found and/or method applied in restoring or reestablishing corner:

- 1995: Found 1/2" iron rod at intersection of road centerline and N-S fence lines.
 Found the following witnesses with roofing nail tags with flagging as per
 1991 Lewis Survey: Cor. Fe. Post - South - 32.69', leaning Cor. Fe. Post -
 North - 33.69', and leaning Fe. Post - N50W - 51.05'.

The position of this corner is compatible with county and local surveys
 and is accepted as a careful and faithful perpetuation of the position
 of the original corner.

AUG 23 1995


Commissioner

Description of monument for corner and accessories established to perpetuate locating the position of the corner:

- 1995: Set 3" dia. aluminum cap, stamped to identify the corner, over the
 existing 1/2" iron rod.
 Reestablished witnesses are:
 Cor. Fe. Post - S6W - 32.69'
 Set tag #31591 in 3" Ash - N15E - 34.52'
 Set tag #31591 in 4" Spruce - S8W - 30.00'
 Set tag #31591 in 3" Spruce - S60W - 52.28'

P.A. 345 ALPENA COUNTY
 PEER APPROVED May 18, 1995
Pat B. Latta

Signed by Thomas L. Fabis
 Surveyor's Michigan License No. 31591

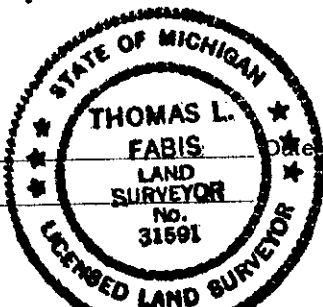

June 12, 1995