

1995 ALPENA COUNTY REMONUMENTATION CORNER

LAND CORNER RECORDATION CERTIFICATE  
Filing Requirement of Act 74, Mich. P.A. 1970

JUN 16 2:52 PM '95

*Thomas L. Fabis*  
REGISTER OF DEEDS

Public Land Survey	Located In:	Corner Code #:
Alpena (County)	T 29N R 6E	M-3 (NE, 12)
	T R	Ossineke Twp.
	T R	
	T R	
Property Controlling in Section	S T R	
Miscellaneous	S T R	
Property in Sec.	S T R	

Register of Deeds Stamp & File Number

Lot No. \_\_\_\_\_, Recorded Plat \_\_\_\_\_  
Private Claims \_\_\_\_\_

A	B	C	D	E	F	G	H	I	J	K	L	M
2	6	5	4	3	2							
3												
4	7	8	9	10	11	12						
5												
6	18	17	16	15	14	13						
7												
8	19	20	21	22	23	24						
9												
10	30	29	28	27	26	25						
11												
12	31	32	33	34	35	36						
13												

Thomas L. Fabis, in a field survey on March 23, 1995, hereby certify that under requirements of P.A. 74, Michigan P.A. of 1970, the corner points mentioned in lines 1 and 2 above were in conformance with regulations and rules therefore as required in the current manual of survey instructions of the United States Department of the Interior, Bureau of Land Management or by a decree of a Court of Law and/or that the corner points mentioned in lines 3, 4 and 5 above were in conformance with the rules of the Michigan Board of Land Surveyors or by a Decree of a Court of Law; established, re-established, monumented, re-monumented, recovered, found as expressed below:

NOTE: Not more than 4 corners, all in the same town and range, may be recorded on this certificate.

Description of original monument and accessories and/or subsequent restoration:

- 1839: G.L.O. Survey by Lewis Clason - Set post & referenced: (Cedar 9 - N51W - 37, Cedar 14 - S39E - 26).
- 1904: County Survey by Jos. W. McNeil - Set cedar stake 3" sq. & referenced.
- 1978: Recorded Survey by David B. Guthrie - Found 3/4" iron rod & referenced.
- 1992: Recorded Survey by David B. Guthrie - Found 1/2" iron rod & referenced.

Description of corner evidence found and/or method applied in restoring or reestablishing corner:

- 1995: Found 3/4" iron rod and the following witnesses tagged P.S.#22435 as per 1992 Recorded Survey by David B. Guthrie: Cor. Fe. Post - N65W - 97.00', P. Pole - N24E - 43.40', and Gate Post - S62E - 92.41').

The position of this corner is compatible with county and local surveys and is accepted as a careful and faithful perpetuation of the position of the original corner.

AUG 23 1995

COMMISSION


Description of monument for corner and accessories established to perpetuate locating the position of the corner:

- 1995: Removed existing corner material and set 1/2" iron rod with 3" dia. aluminum cap, stamped to identify the corner.

Reestablished witnesses are:

- Existing tag #22435 in Cor. Fe. Post - N65W - 97.00'
- Exis. tag #22435 in P. Pole - N24E - 43.40'
- Exis. Tag #22435 in Gate Post - S62E - 92.41'
- Exis. property corner #27461 - S42W - 61.52'

Signed by *Thomas L. Fabis*  
Surveyor's Michigan License No. 31591

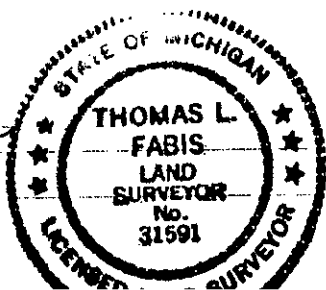

Date

P.A. 345 ALPENA COUNTY  
PEER APPROVED *May 18, 1995*  
*W.P. Loh*  
*June 12, 1995*