

**LAND CORNER RECORDATION CERTIFICATE**  
**Filing Requirement of Act 74, Mich. P.A. 1970**

For corners in

<u>Alpena</u> (County)	Located In:	Corner Code #
1. Public Land Survey	T <u>29N</u> R <u>6E</u>	<u>I-2</u>
	T <u>29N</u> R <u>6E</u>	<u>I-3</u>
2. Property Controlling in Section	S _____ T _____ R _____	_____
	S _____ T _____ R _____	_____
3. Miscellaneous Property in Sec.	S _____ T _____ R _____	_____
	S _____ T _____ R _____	_____

Register of Deeds Stamp & File Num

4. Lot No. \_\_\_\_\_, Recorded Plat \_\_\_\_\_

5. Private Claims \_\_\_\_\_

I, Carl T. Kiiskila, in a field survey on July 15, 19 97 do hereby state that under requirements of P.A. 74, Michigan P.A. of 1970, the corner points mentioned in lines 1 and 2 above were in conformance with regulations and rules therefore as required in the current manual of survey instructions of the United States Department of the Interior, Bureau of Land Management or by a decree of a Court of Law and /or that the corner points mentioned in lines 3, 4 and 5 above were in conformance with the rules of the Michigan Board of Land Surveyors or by a Decree of a Court of Law; established, re-established, monumented, recovered, found as expressed below:

	A	B	C	D	E	F	G	H	I	J	K	L	M
1													
2		6		5		4		3	●	2		1	
3									●				
4		7		8		9		10		11		12	
5													
6		18		17		16		15		14		13	
7													
8		19		20		21		22		23		24	
9													
10		30		29		28		27		26		25	
11													
12		31		32		33		34		35		36	
13													

**NOTE:** Not more than 2 corners, all in the same town and range, may be recorded on this certificate.

**A. Description of original monument and accessories and/or subsequent restoration:**

I-2 GLO set section post – Lewis Clason 1839.  
 Wit: Beech 6" S 61° E 21 links  
 Beech 14" N 39° W 8 links

I-3 GLO set section post.  
 Wit: Beech 8" N 31° E 23 links  
 Soft Maple 13" S 20° W 71 links

Joseph McNeil in 1904 reset this corner by measuring 11.55 chains south from a 30" White Pine line tree and set a large cedar stake.

**B. Description of corner evidence found and/or method applied in restoring or reestablishing corner:**

I-2 Found and accepted a 1/2" rerod 2' east of the centerline of a north-south gravel road in line with a good fence west.


I-3 Reestablished the Southwest Corner of Section 2 by doubling over J-3 from K-3 and prorating Joseph McNeil's east half of the south line of Section 2 to the west half of the south line of Section 2. This position fits well with his stream tie south to Wolf Creek on May 2, 1904.

**C. Description of monument for corner and accessories established to perpetuate locating the position of the corner:**

I-2 Found 1/2" iron rod.  
 Wit: Set nail in 4" Maple clump S 88° W 53.33'  
 Set nail in 6" Oak S 48° E 53.75'  
 \* Set nail in 6" Oak N 45° E 60.39'  
 Set nail in 14" Scotch Pine N 39° W 66.36'  
 Centerline of north-south county road West 2±  
 \* (old witness by Lewis & Lewis)

I-3 Set 5/8" x 32" rerod with cap.  
 Wit: Set nail in 36" twin Oak N 57° E 66.92'  
 Set nail in 18" Oak N 48° W 79.78'  
 Set nail in 12" Oak South 54.08'  
 Utility pole S 52° W 44.74'  
 Centerline intersection of east-west and north roads.

Signed by Carl T. Kiiskila  
 Surveyor's Michigan License No. 33981

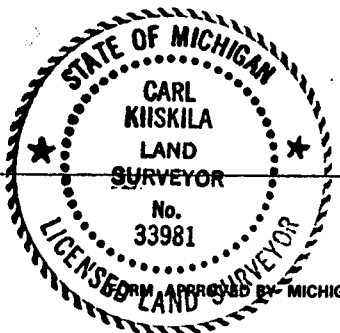

Date 6-14-99