


**LAND CORNER RECORDATION CERTIFICATE**  
**Filing Requirement of Act 74, Mich. P.A. 1970**

For corners in

<u>Alpena</u> (County)	Located In:	Corner Code #
1. Public Land Survey	T <u>29N</u> R <u>6E</u>	<u>K-7</u>
	T _____ R _____	_____
2. Property Controlling in Section	S <u>11</u> T <u>29N</u> R <u>6E</u>	<u>16</u>
	S _____ T _____ R _____	_____
3. Miscellaneous Property in Sec.	S _____ T _____ R _____	_____
	S _____ T _____ R _____	_____

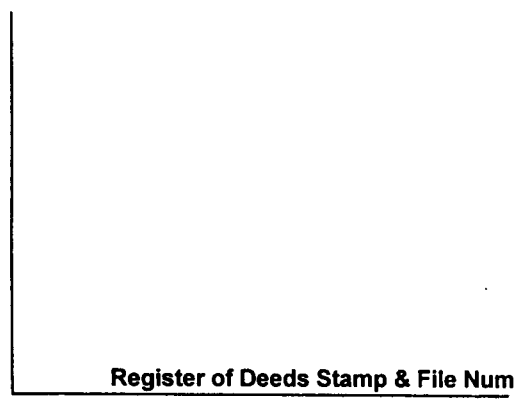

4. Lot No. \_\_\_\_\_, Recorded Plat \_\_\_\_\_

5. Private Claims \_\_\_\_\_

I, Carl T. Kiiskila, in a field survey on Aug. 12, 19 97 do hereby state that under requirements of P.A. 74, Michigan P.A. of 1970, the corner points mentioned in lines 1 and 2 above were in conformance with regulations and rules therefore as required in the current manual of survey instructions of the United States Department of the Interior, Bureau of Land Management or by a decree of a Court of Law and /or that the corner points mentioned in lines 3, 4 and 5 above were in conformance with the rules of the Michigan Board of Land Surveyors or by a Decree of a Court of Law; established, re-established, monumented, recovered, found as expressed below:

1	A	B	C	D	E	F	G	H	I	J	K	L	M
2		6		5		4		3		2			1
3													
4		7		8		9		10		11			12
5											●		
6		18		17		16		15		14			13
7											●		
8		19		20		21		22		23			24
9													
10		30		29		28		27		26			25
11													
12		31		32		33		34		35			36
13													

**NOTE:** Not more than 2 corners, all in the same town and range, may be recorded on this certificate.

**A. Description of original monument and accessories and/or subsequent restoration:**

- K-7 GLO set section post – Lewis Clason D.S. 1839.  
 Wit: Hard Maple 7" N 44° E 15 links  
 Yellow Pine 20" S 34° W 63 links
- 16 - This position was not established during the original government survey.


**B. Description of corner evidence found and/or method applied in restoring or reestablishing corner:**

- K-7 Found and accepted a 1/2" pin in concrete believed to be set by R. S. Scott and Associates. This position has been used by area surveyors for surveys in the vicinity.
- 16 - Established the Southwest Corner of the Southeast Quarter of the Southeast Quarter of Section 11 per standard BLM instructions for subdivision of a section.

**C. Description of monument for corner and accessories established to perpetuate locating the position of the corner:**

- K-7 Found concrete monument in road intersection.  
 Wit: Set nail in 3" Russian Olive N 74° W 124.02'  
 Set nail in 22" Red Pine S 46° W 65.89'  
 Power pole N 50° E 45.83'  
 Power pole S 61° E 113.10'
- 16 - Set 5/8" x 32" rerod with cap and set carsonite marker post.  
 Wit: Set nail in 5" Maple S 47° W 21.01'  
 Utility pole gate post S 73° W 41.63'  
 Utility pole gate post N 77° W 40.92'  
 Set nail in 5" Maple N 2° W 27.88'  
 Carsonite post set South 15' ±

Signed by Carl T Kiiskila  
 Surveyor's Michigan License No. 33981

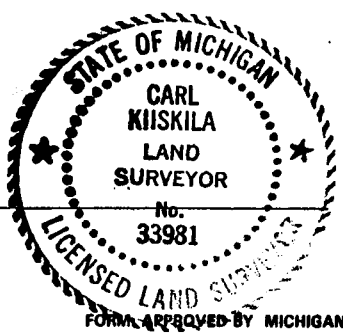

Date 6-14-99