

LAND CORNER RECORDATION CERTIFICATE
Filing Requirement of Act 74, Mich. P.A. 1970

For corners in

<u>Alpena</u> (County)	Located In:	Corner Code #
1. Public Land Survey	T <u>29N</u> R <u>6E</u>	<u>H-1</u>
	T <u>29N</u> R <u>6E</u>	<u>G-1</u>
2. Property Controlling in Section	S _____ T _____ R _____	_____
	S _____ T _____ R _____	_____
3. Miscellaneous Property in Sec.	S _____ T _____ R _____	_____
	S _____ T _____ R _____	_____

Register of Deeds Stamp & File Num

4. Lot No. _____, Recorded Plat _____

5. Private Claims _____

I, Carl T. Kiiskila, in a field survey on Oct. 29, 19 97 do hereby state that under requirements of P.A. 74, Michigan P.A. of 1970, the corner points mentioned in lines 1 and 2 above were in conformance with regulations and rules therefore as required in the current manual of survey instructions of the United States Department of the Interior, Bureau of Land Management or by a decree of a Court of Law and /or that the corner points mentioned in lines 3, 4 and 5 above were in conformance with the rules of the Michigan Board of Land Surveyors or by a Decree of a Court of Law; established, re-established, monumented, recovered, found as expressed below:

1	A	B	C	D	E	F	G	H	I	J	K	L	M
2		6		5		4		3		2		1	
3													
4		7		8		9		10		11		12	
5													
6		18		17		16		15		14		13	
7													
8		19		20		21		22		23		24	
9													
10		30		29		28		27		26		25	
11													
12		31		32		33		34		35		36	
13													

NOTE: Not more than 2 corners, all in the same town and range, may be recorded on this certificate.

A. Description of original monument and accessories and/or subsequent restoration:

- | | |
|------------------------------------------------------------------------------|---|
| H-1 This position was not established during the original government survey. | G-1 GLO - Intersect boundary 70 links east of post.
Wit: Hemlock 14" S 18° W 31 links
Fir 8" S 61° E 42 links |
|------------------------------------------------------------------------------|---|
- Page 332, County Survey Notes, Joseph W. McNeil
 May 25, 1910 set corner 46 1/2 links East of South quarter corner Section 34, T 30 N, R 6 E.


B. Description of corner evidence found and/or method applied in restoring or reestablishing corner:

- | | |
|---|--------------------------------------------------------------------------------------------|
| H-1 Reestablished the North quarter corner of Section 3 on line between the South quarter corner and Southeast corner of Section 34, T 30 N, R 6 E 46 1/2 links (30.7') East of the South quarter corner Section 34. | G-1 Found a concrete monument that fits the closing distances and falling reasonably well. |
|---|--------------------------------------------------------------------------------------------|

C. Description of monument for corner and accessories established to perpetuate locating the position of the corner:

- | | |
|---|---|
| H-1 Set 5/8" x 32" rerod with cap.
Wit: Power pole S 65° W 63.24'
Power pole S 58° E 68.34'
Set nail in 12" Red Pine N 51° E 52.40'
Set nail in 24" Oak N 50° W 95.44'
Carsonite marker post South 33'
1/2" rerod in centerline of east-west and road north West 30.70' | G-1 Found concrete monument in centerline of east-west gravel road.
Wit: Wooden fence post S 37° W 36.77'
Set nail in 4" Spruce N 25° W 34.72'
Set nail in 6" Oak N 20° E 29.81'
Set nail in 7" Maple S 17° E 60.45'
Carsonite marker post South 33' |
|---|---|

Signed by Carl T. Kiiskila
 Surveyor's Michigan License No. 33981

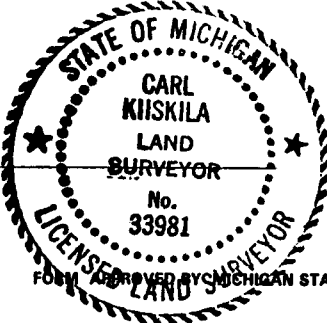

Date 6-14-99

APPROVED BY MICHIGAN STATE BOARD OF PROFESSIONAL SURVEYORS, JAN. 28, 1971
 REVISED MAY 14, 1975
 REVISED JAN., 1983
 REVISED OCT., 1995