

**SURVEY & REMONUMENTATION**

FEB 03 1998

1997 Alpena County Remonumentation Corner  
**LAND CORNER RECORDATION CERTIFICATE**  
 Filing Requirement of Act 74, Mich. P.A. 1970

**SECTION**

For corners in

Alpena

(County)

Located In:

Corner Code #

1. Public Land Survey

T29N R6E

M-7

T29N R7E

A-7

T R

T R

2. Property Controlling in Section

S T R

S T R

3. Miscellaneous Property in Sec.

S T R

S T R

Liber **00002** Page **0121**

STATE OF MICHIGAN  
 County of Alpena  
 Recorded  
 11-06-1997 15:32:00  
 Kathy J. Matash  
 REGISTER OF DEEDS

Register of Deeds Stamp & File Number

4. Lot No. \_\_\_\_\_, Recorded Plat \_\_\_\_\_

5. Private Claims \_\_\_\_\_

I, Daniel T. Kibbe, in a field survey on March 27, 1997 do hereby state that under requirements of P.A. 74, Michigan P.A. of 1970, the corner points mentioned in lines 1 and 2 above were in conformance with regulations and rules therefore as required in the current manual of survey instructions of the United States Department of the Interior, Bureau of Land Management or by a decree of a Court of Law and /or that the corner points mentioned in lines 3, 4 and 5 above were in conformance with the rules of the Michigan Board of Land Surveyors or by a Decree of a Court of Law; established, re-established, monumented, recovered, found as expressed below:

NOTE: Not more than 2 corners, all in the same town and range, may be recorded on this certificate.

P.A. 345 ALPENA COUNTY  
 PEER APPROVED 7/23/97  
*Daniel T. Kibbe*

1	A	B	C	D	E	F	G	H	I	J	K	L	M
2		6		5		4		3		2		1	
3													
4		7		8		9		10		11		12	
5													
6		16		17		16		15		14		13	
7													
8		19		20		21		22		23		24	
9													
10		30		29		28		27		26		25	
11													
12		31		32		33		34		35		36	
13													

A. Description of original monument and accessories and/or subsequent restoration:

- 1839: GLO survey by Lewis Clason - set post, referenced: Y. Birch 20-S57W-59 / Cedar 14-N12W-24
- 1911: County survey by Jos. W. McNeil - set large cedar stake, referenced: O.B.T. standing Y. Birch 20-S57W-59 remains of other two O.B.T.'s, N.B.T.'s: Cedar Stump 14-S57W-42 / Willow 6-S26E-34
- 1979: Survey by Duane R. MacNeill - set 1" pipe, referenced: N45W - 48.81' Power Pole / S45W - 44.22' Fence corner / S45E - 44.12' Fence corner
- 1993: Survey by David Guthrie - existing 1" pipe (DRM)
- 1996: County Road Commission Survey - found pipe w/cap, referenced: N43E - 49.30' Fence Corner / N38W - 47.08' Power Pole / N58W - 80.12' 3" Spruce

B. Description of corner evidence found and/or method applied in restoring or reestablishing corner:

- 1997: Survey by Wayne Lewis - Found pipe and cap, referenced: N60W - 80.25' 4" Balsam / N45W - 47.30' P. Pole / N45E - 49.40' Fence Post / S60E - 94.60' 8" Elm


B.

- 1997: Found 1" pipe and cap 2' South of E-W centerline road, in centerline road to North, 2' West of centerline road to South.

This corner position is compatible with county & local surveys. This corner position is accepted as a careful and faithful perpetuation of the position of the original corner.

C. Description of monument for corner and accessories established to perpetuate locating the position of the corner:

- 1997: Placed 3" Alpena County cap stamped to identify the corner over 1/2" iron rod  
 Referenced:  
 N55W - 80.15' - Found tag in 4" Balsam  
 N34W - 47.15' - Found tag in P. Pole  
 S63E - 94.45' - Found tag in 8" Elm  
 N46E - 49.44' - Found tag in Fence Post  
 S41E - 45.38' - Found old tag in corner fence post bent SE

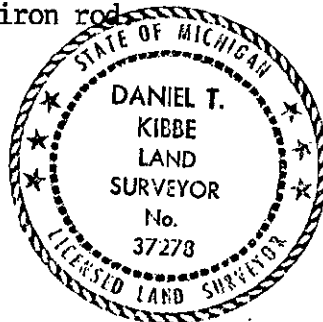

Signed by *Daniel T. Kibbe*

Date October 24, 1997

Surveyor's Michigan License No. 37278