

SURVEY & REMONUMENTATION

FEB 03 1998

1997 Alpena County Remonumentation Corner
LAND CORNER RECORDATION CERTIFICATE
 Filing Requirement of Act 74, Mich. P.A. 1970

For corners in **SECTION**

Alpena
 (County)

Located In:	Corner Code #
T29N R 7E	C-4
T R	
T R	
T R	
S T R	
S T R	
S T R	
S T R	


- Public Land Survey
- Property Controlling in Section
- Miscellaneous Property in Sec.

Liber **00002** Page **0109**

STATE OF MICHIGAN
 County of Alpena
 Recorded
 11-06-1997 15:29:46
 Kathy J. Matash
 REGISTER OF DEEDS

Register of Deeds Stamp & File Number

- Lot No. _____, Recorded Plat _____
- Private Claims _____

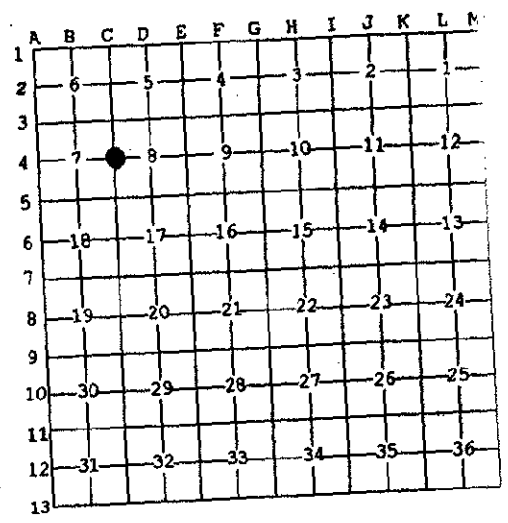

I, Daniel T. Kibbe, in a field survey on August 12, 1997 do hereby state that under requirements of P.A. 74, Michigan P.A. of 1970, the corner points mentioned in lines 1 and 2 above were in conformance with regulations and rules therefore as required in the current manual of survey instructions of the United States Department of the Interior, Bureau of Land Management or by a decree of a Court of Law and /or that the corner points mentioned in lines 3, 4 and 5 above were in conformance with the rules of the Michigan Board of Land Surveyors or by a Decree of a Court of Law; established, re-established, monumented, recovered, found as expressed below:

NOTE: Not more than 2 corners, all in the same town and range, may be recorded on this certificate.

P.A. 345 ALPENA COUNTY
 PEER APPROVED 7/23/97
Daniel B. Carter


- A. Description of original monument and accessories and/or subsequent restoration:
- 1839: GLO survey by Lewis Clason - set 1/4 post, referenced: Beech 16-S51E-25 / Beech 12-N76W-27
 - 1896: County survey by Fred A. Rice - existing corner, referenced: Beech 8"-N45W-49 links / Beech 9"-N76W-27
 - 1914: County survey by Jos. W. McNeil - Found in road bed, set new stake
 - 1977: Survey by David Guthrie - existing nail, set 1/2" iron, referenced: N20E-Power Pole-123.30' S80E-Power Pole-33.25' / S80W-Power Pole-155.30'
 - 1992: Survey by David Guthrie - existing P.K. nail in bit road, referenced: S77E-33.10'-Power Pole / N60W-40.15'-center top of tele. junct. box / S65W-48.14'-Krueger Rd. sign post / S78W-53.41'-stop sign post

- B. Description of corner evidence found and/or method applied in restoring or reestablishing corner:
- 1997: Found 1/2" rebar set by David Guthrie, fits existing witnesses, is in centerline N-S road, 2' North of centerline road to West. Also found and accepted as the true corner position was a 1 1/2" square iron bar 1' below road grade. This corner position is 2' East and 9' South of found rebar and cap. This corner position is 2' East of centerline N-S road, 7' South of centerline road to West and is on Fence line to East. This corner position is compatible with 1/8 line fences North and South.

This corner position is compatible with county & local surveys. This corner position is accepted as a careful and faithful perpetuation of the position of the original corner.

- C. Description of monument for corner and accessories established to perpetuate locating the position of the corner:
- 1997: Placed 3" Alpena County cap stamped to identify the corner over 1/2" iron rod in monument box.

- Referenced:
- N50W - 47.31' - top center of tele. junction box
 - S85E - 29.48' - set tag above bent tag in power pole
 - S85W - 31.30' - stop sign
 - East 31.30' - top center of tele. junction box
 - N10W - 9.3' - bar and cap

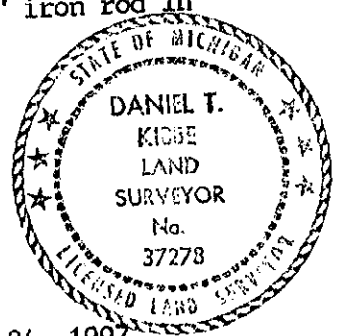

Signed by *Daniel T. Kibbe*
 Surveyor's Michigan License No. 37278

Date October 24, 1997