

# SURVEY & REMONUMENTATION

FEB 03 1998

## 1997 Alpena County Remonumentation Corner. LAND CORNER RECORDATION CERTIFICATE Filing Requirement of Act 74, Mich. P.A. 1970

### SECTION

For corners in

<u>Alpena</u> (County)	Located In:	Corner Code #
1. Public Land Survey	T <u>29</u> N R <u>7</u> E	<u>C-5</u>
	T ___ R ___	_____
	T ___ R ___	_____
	T ___ R ___	_____
2. Property Controlling in Section	S ___ T ___ R ___	_____
	S ___ T ___ R ___	_____
3. Miscellaneous Property in Sec.	S ___ T ___ R ___	_____
	S ___ T ___ R ___	_____

Liber **00002** Page **0110**  
STATE OF MICHIGAN  
County of Alpena  
Recorded  
11-06-1997 15:30:02  
Kathy J. Matash  
REGISTER OF DEEDS

Register of Deeds Stamp & File Number

4. Lot No. \_\_\_\_\_, Recorded Plat \_\_\_\_\_  
5. Private Claims \_\_\_\_\_

I, Daniel T. Kibbe, in a field survey on March 27, 1997 do hereby state that under requirements of P.A. 74, Michigan P.A. of 1970, the corner points mentioned in lines 1 and 2 above were in conformance with regulations and rules therefore as required in the current manual of survey instructions of the United States Department of the Interior, Bureau of Land Management or by a decree of a Court of Law and/or that the corner points mentioned in lines 3, 4 and 5 above were in conformance with the rules of the Michigan Board of Land Surveyors or by a Decree of a Court of Law; established, re-established, monumented, recovered, found as expressed below:

NOTE: Not more than 2 corners, all in the same town and range, may be recorded on this certificate.

P.A. 345 ALPENA COUNTY  
PEER APPROVED 7/23/97  
*D. B. [Signature]*

1	A	B	C	D	E	F	G	H	I	J	K	L
2		6		5		4		3		2		1
3												
4		7		8		9		10		11		12
5												
6		18		17		16		15		14		13
7												
8		19		20		21		22		23		24
9												
10		30		29		28		27		26		25
11												
12		31		32		33		34		35		36
13												


- A. Description of original monument and accessories and/or subsequent restoration:
- 1839: GLO survey by Lewis Clason - set post, referenced: Beech 15"-N42E-16 / Beech 9-S35W-59
  - 1896: County survey by Jos. McNeil - exist. corner, set 4" square cedar stake, referenced: Maple 6" - N33 3/4W - 53 1/2 links
  - 1977: Survey by David Guthrie - Set 1/2" rebar by setting 33' from fences, referenced: S40E - 42.5' Power Pole / N45E - 46.10' - Fence Corner / N45W - 48.20' - 12" Maple
  - 1981: Survey by Earl T. Lewis - fd. iron rod, referenced: N45W-48.35' - 12" Basswood / S45E - 43.6' - Power Pole / N45E - 46.2' - Fence Post
  - 1997: Survey by Wayne Lewis - exis. nail, referenced: N45W - 56.45' - 18" Ash / N40W - 87.7' - Cemetery Marker / N35W - 59.50' - 8" Beech / S65E - 43.72' - P. Pole

B. Description of corner evidence found and/or method applied in restoring or reestablishing corner:  
1997: Found bar and cap in centerline of intersection

This corner position is compatible with county & local surveys. This corner position is accepted as a careful and faithful perpetuation of the position of the original corner.

C. Description of monument for corner and accessories established to perpetuate locating the position of the corner:  
1997: Placed 3" Alpena County cap stamped to identify the corner over 1/2" iron rod in monument box.

- Referenced:
- S38E - 43.75' - Found tag in P. Pole
  - N19W - 83.27' - Found tag in 8" Maple
  - N30W - 59.25' - Found tag in 8" Maple
  - N49W - 56.23' - Found tag in 22" Ash

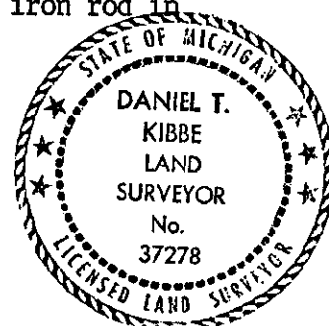

Signed by *Daniel T. Kibbe*  
Surveyor's Michigan License No. 37278

Date October 24, 1997