

SURVEY & REMONUMENTATION

FEB 03 1998

1997 Alpena County Remonumentation Survey
LAND CORNER RECORDATION CERTIFICATE
 Filing Requirement of Act 74, Mich. P.A. 1970

SECTION

For corners in

Alpena
 (County)

Located In:

Corner Code #

1. Public Land Survey

T 29 N R 7E C-6
 T ___ R ___
 T ___ R ___
 T ___ R ___

2. Property Controlling in Section

S ___ T ___ R ___
 S ___ T ___ R ___
 S ___ T ___ R ___
 S ___ T ___ R ___

3. Miscellaneous Property in Sec.

Liber **00002** Page **0111**

STATE OF MICHIGAN
 County of Alpena
 Recorded
 11-06-1997 15:30:12
 Kathy J. Matash
 REGISTER OF DEEDS

Register of Deeds Stamp & File Number

4. Lot No. _____, Recorded Plat _____
 5. Private Claims _____

I, Daniel T. Kibbe, in a field survey on March 27, 1997 do hereby state that under requirements of P.A. 74, Michigan P.A. of 1970, the corner points mentioned in lines 1 and 2 above were in conformance with regulations and rules therefore as required in the current manual of survey instructions of the United States Department of the Interior, Bureau of Land Management or by a decree of a Court of Law and /or that the corner points mentioned in lines 3, 4 and 5 above were in conformance with the rules of the Michigan Board of Land Surveyors or by a Decree of a Court of Law, established, re-established, monumented, recovered, found as expressed below:

A	B	C	D	E	F	G	H	I	J	K	L	M
1												
2	6		5		4		3		2		1	
3												
4	7		8		9		10		11		12	
5												
6	18		17		16		15		14		13	
7												
8	19		20		21		22		23		24	
9												
10	30		29		28		27		26		25	
11												
12	31		32		33		34		35		36	
13												

NOTE: Not more than 2 corners, all in the same town and range, may be recorded on this certificate.

P.A. 345 ALPENA COUNTY
 PEER APPROVED 7/23/97
D. T. Kibbe


- A. Description of original monument and accessories and/or subsequent restoration:
- 1839: GLO survey by Lewis Clason - set $\frac{1}{4}$ post, referenced: Y. Birch 12-S78E-26 / Hem 24"-N22W-33
 - 1896: County survey by Fred A. Rice - exist. corner, referenced: Cedar stake 3" square - E-50 links / Cedar stake 3" square - W-50 links
 - 1911: County survey by Jos. W. McNeil - replaced Corner in road
 - 1978: County Road Commission Survey by Gary St. Charles - fd. $\frac{1}{2}$ " rerod 3'-4' East of Centerline
 - 1986: Survey by David Guthrie - exist. $\frac{1}{2}$ " iron rod, referenced: N80W-6" Elm - 37.37' / East - Utility Pole - 38.96' / S80W-4" Apple - 41.78'
 - 1997: Survey by Wayne T. Lewis - existing $\frac{1}{2}$ " rerod, referenced: East 39.00' - power pole / S30E 105.55' - tele. maker / West - 41.90' - 6" Apple

- B. Description of corner evidence found and/or method applied in restoring or reestablishing corner:
- 1997: Found $\frac{1}{2}$ " rebar 4' East of N-S centerline road on old fence/tree line to West.

This corner position is compatible with county & local surveys. This corner position is accepted as a careful and faithful perpetuation of the position of the original corner.

- C. Description of monument for corner and accessories established to perpetuate locating the position of the corner:
- 1997: Placed 3" Alpena County cap stamped to identify the corner over $\frac{1}{2}$ " iron rod in monument box.

- Referenced:
- S83E - 44.35' - fd. tag in Fence Post
 - S82W - 41.77' - fd. tag in 6" Apple
 - S05E - 105.91' - center top of tele riser junction box
 - S83E - 38.94' - fd. tag in P. Pole

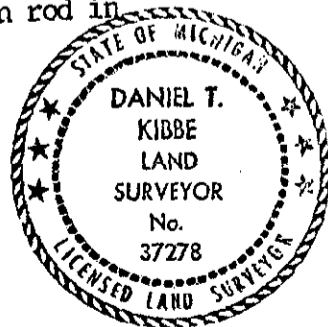

Signed by *Daniel T. Kibbe*
 Surveyor's Michigan License No. 37278

Date October 24, 1997