

SURVEY & REMONUMENTATION

FEB 03 1998

1997 Alpena County Remonumentation Corner
LAND CORNER RECORDATION CERTIFICATE
 Filing Requirement of Act 74, Mich. P.A. 1970

For corners in **SECTION**

Alpena
 (County)

Located In:

Corner Code #

1. Public Land Survey

T29N R7E C-9

T R

T R

T R

2. Property Controlling in Section

S T R

S T R

3. Miscellaneous Property in Sec.

S T R

S T R

4. Lot No. , Recorded Plat

5. Private Claims

Liber **00002** Page **0114**

STATE OF MICHIGAN
 County of Alpena
 Recorded
 11-06-1997 15:30:51
 Kathy J. Matash
 REGISTER OF DEEDS

Register of Deeds Stamp & File Number

	A	B	C	D	E	F	G	H	I	J	K	L	M
1													
2	6		5		4		3		2		1		
3													
4	7		8		9		10		11		12		
5													
6	18		17		16		15		14		13		
7													
8	19		20		21		22		23		24		
9													
10	30		29		28		27		26		25		
11													
12	31		32		33		34		35		36		
13													

I, Daniel T. Kibbe, in a field survey on March 27, 1997 do hereby state that under requirements of P.A. 74, Michigan P.A. of 1970, the corner points mentioned in lines 1 and 2 above were in conformance with regulations and rules therefore as required in the current manual of survey instructions of the United States Department of the Interior, Bureau of Land Management or by a decree of a Court of Law and/or that the corner points mentioned in lines 3, 4 and 5 above were in conformance with the rules of the Michigan Board of Land Surveyors or by a Decree of a Court of Law; established, re-established, monumented, recovered, found as expressed below:

NOTE: Not more than 2 corners, all in the same town and range, may be recorded on this certificate.


P.A. 345 ALPENA COUNTY
 PEER APPROVED 7/23/97
D. B. Lewis

- A. Description of original monument and accessories and/or subsequent restoration:
- 1839: GLO survey by Lewis Clason - set post, referenced: Hem 18-N36E-28 / Beech 14-S33W-50
 - 1905: County survey by Fred A. Rice - fd. old stake and set new one beside it and large bottle filled with sand beside stake
 - 1905: County survey by Jos. W. McNeil - set new cedar stake in place of old one with large bottle of sand beside same
 - 1914: County survey by Jos. W. McNeil - an iron bolt with a bottle beside for corner
 - 1994: Survey by Earl T. Lewis - exist. 1/2" rebar raised with 1/2" rebar, referenced: N45E - 45.1' - Power pole / N45W - 39.0' - Guy Pole / S45W - 59.5' - Power Pole / S45E - 52.25' - Tel. Marker

- B. Description of corner evidence found and/or method applied in restoring or reestablishing corner:
- 1997: Found 1/2" rebar in centerline N-S road and 5' North of centerline road to East.

This corner position is compatible with county & local surveys. This corner position is accepted as a careful and faithful perpetuation of the position of the original corner.

- C. Description of monument for corner and accessories established to perpetuate locating the position of the corner:
- 1997: Placed 3" Alpena County cap stamped to identify the corner over 1/2" iron rod.
- Referenced:
- N62W - 45.95' - Found tack w/flagging, set tag in power pole
 - N41W - 38.41' - Set tag in Power Pole
 - S52W - 59.47' - Found tag w/flagging, set tag in power pole
 - S32E - 52.09' - Telephone riser

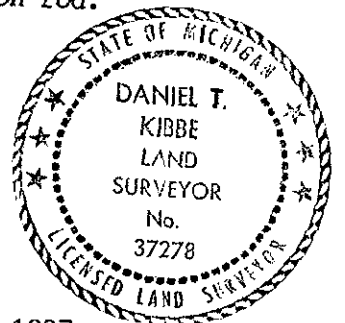

Signed by *Daniel T. Kibbe*
 Surveyor's Michigan License No. 37278

Date October 24, 1997