

SURVEY & REMONUMENTATION

FEB 03 1998

1997 Alpena County Remonumentation Corner LAND CORNER RECORDATION CERTIFICATE Filing Requirement of Act 74, Mich. P.A. 1970

SECTION

For corners in

| Alpena (County) | Located In: | Corner Code # |
|------------------------------------|----------------|---------------|
| 1. Public Land Survey | T29N R7E | C-11 |
| | T___ R___ | _____ |
| | T___ R___ | _____ |
| | T___ R___ | _____ |
| 2. Property Controlling in Section | S___ T___ R___ | _____ |
| | S___ T___ R___ | _____ |
| 3. Miscellaneous Property in Sec. | S___ T___ R___ | _____ |
| | S___ T___ R___ | _____ |

Liber 00002 Page 0116
 STATE OF MICHIGAN
 County of Alpena
 Recorded
 11-06-1997 15:31:14
 Kathy J. Natash
 REGISTER OF DEEDS

Register of Deeds Stamp & File Number

4. Lot No. _____, Recorded Plat _____
 5. Private Claims _____

I, Daniel T. Kibbe, in a field survey on March 27, 1997 do hereby state that under requirements of P.A. 74, Michigan P.A. of 1970, the corner points mentioned in lines 1 and 2 above were in conformance with regulations and rules therefore as required in the current manual of survey instructions of the United States Department of the Interior, Bureau of Land Management or by a decree of a Court of Law and/or that the corner points mentioned in lines 3, 4 and 5 above were in conformance with the rules of the Michigan Board of Land Surveyors or by a Decree of a Court of Law; established, re-established, monumented, recovered, found as expressed below:

NOTE: Not more than 2 corners, all in the same town and range, may be recorded on this certificate.

P.A. 345 ALPENA COUNTY
 PEER APPROVED 7/23/97
Det. B. Turner

| | A | B | C | D | E | F | G | H | I | J | K | L | M |
|----|---|----|---|----|---|----|---|----|---|----|---|----|---|
| 1 | | | | | | | | | | | | | |
| 2 | | 6 | | 5 | | 4 | | 3 | | 2 | | 1 | |
| 3 | | | | | | | | | | | | | |
| 4 | | 7 | | 8 | | 9 | | 10 | | 11 | | 12 | |
| 5 | | | | | | | | | | | | | |
| 6 | | 18 | | 17 | | 16 | | 15 | | 14 | | 13 | |
| 7 | | | | | | | | | | | | | |
| 8 | | 19 | | 20 | | 21 | | 22 | | 23 | | 24 | |
| 9 | | | | | | | | | | | | | |
| 10 | | 30 | | 29 | | 28 | | 27 | | 26 | | 25 | |
| 11 | | | | | | | | | | | | | |
| 12 | | 31 | | 32 | | 33 | | 34 | | 35 | | 36 | |
| 13 | | | | | | | | | | | | | |


A. Description of original monument and accessories and/or subsequent restoration:
 1839: GLO survey by Lewis Clason - set post, referenced Hem 26-S52E-18 / Hd Maple 16-N69W-26
 1912: County survey by Jos. W. McNeil - fd. section corner
 1978: Survey by David Guthrie - two exist. 1/2" rebar
 1994: Survey by Earl T. Lewis - fd. exist. 1/2" rebar, referenced: N45W-49.7'-power pole / N45E-50.0'-power pole / S45E-66.6'-tel. pole / S45W-49.6'-stop sign

B. Description of corner evidence found and/or method applied in restoring or reestablishing corner:
 1997: Found 1/2" bar and cap 1.5' South of E-W centerline and 4' West of N-S centerline.

This corner position is compatible with county & local surveys. This corner position is accepted as a careful and faithful perpetuation of the position of the original corner.

C. Description of monument for corner and accessories established to perpetuate locating the position of the corner:
 1997: Placed 3" Alpena County cap stamped to identify the corner over 1/2" iron rod.

- Referenced:
- N51E - 51.55' - fd. tack w/flag, set tag over tack in power pole
 - N24W - 149.57' - set tag in power pole
 - S61E - 89.27' - set tag in 17" Red Pine
 - S80W - 48.86' - stop sign
 - S54W - 77.95' - set tag in 5" Ash

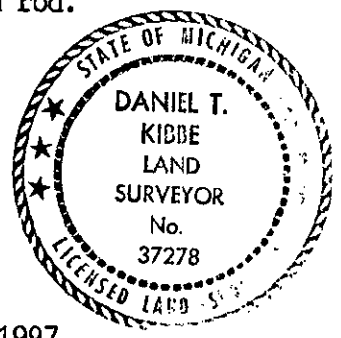

Signed by *Daniel T. Kibbe*
 Surveyor's Michigan License No. 37278

Date October 24, 1997