

SURVEY & REMONUMENTATION

FEB 03 1998

1997 Alpena County Remonumentation Corner
LAND CORNER RECORDATION CERTIFICATE
 Filing Requirement of Act 74, Mich. P.A. 1970

For corners in **SECTION**

<u>Alpena</u> (County)	Located in:	Corner Code #
1. Public Land Survey	T29N R7E	C-13
	T___ R___	_____
	T___ R___	_____
	T___ R___	_____
2. Property Controlling in Section	S___ T___ R___	_____
	S___ T___ R___	_____
3. Miscellaneous Property in Sec.	S___ T___ R___	_____
	S___ T___ R___	_____

Liber **00002** Page **0118**
 STATE OF MICHIGAN
 County of Alpena
 Recorded
 11-06-1997 15:31:33
 Kathy J. Matash
 REGISTER OF DEEDS

Register of Deeds Stamp & File Number

4. Lot No. _____, Recorded Plat _____
 5. Private Claims _____

I, Daniel T. Kibbe, in a field survey on July 11, 1997 do hereby state that under requirements of P.A. 74, Michigan P.A. of 1970, the corner points mentioned in lines 1 and 2 above were in conformance with regulations and rules therefore as required in the current manual of survey instructions of the United States Department of the Interior, Bureau of Land Management or by a decree of a Court of Law and/or that the corner points mentioned in lines 3, 4 and 5 above were in conformance with the rules of the Michigan Board of Land Surveyors or by a Decree of a Court of Law; established, re-established, monumented, recovered, found as expressed below:

NOTE: Not more than 2 corners, all in the same town and range, may be recorded on this certificate.

P.A. 345 ALPENA COUNTY
 PEER APPROVED 7/23/97
D. H. Carter

1	A	B	C	D	E	F	G	H	I	J	K	L	M
2		6		5		4		3		2		1	
3													
4		7		8		9		10		11		12	
5													
6		18		17		16		15		14		13	
7													
8		19		20		21		22		23		24	
9													
10		30		29		28		27		26		25	
11													
12		31		32		33		34		35		36	
13													

A. Description of original monument and accessories and/or subsequent restoration:

- 1839: GLO survey by Lewis Clason - Set post, referenced: Y. Pine 24-N66E-33 / Y. Pine 26-N28W-13
- 1912: County survey by Jos. W. McNeil - Fd remains of both O.B.T.'s and found old line plain in swamp to west of corner, set cedar stake and made new witnesses, referenced: W. Pine Stump 24-N4 1/2 W-113. This town line has been run by someone and a stake set about 70 links to far South and road, fences built according.
- 1978: Survey by David Guthrie - Existing 1" pipe


B. Description of corner evidence found and/or method applied in restoring or reestablishing corner:

- 1997: Found 1/2" rebar centerline of N-S Road, 46.13' North of a found pipe in the intersection of Road N-S & E. This corner position agrees with 1912 Jos. McNeil survey which indicated the corner was 70 links (46.2') North of intersection.

This corner position is compatible with county & local surveys. This corner position is accepted as a careful and faithful perpetuation of the position of the original corner.

C. Description of monument for corner and accessories established to perpetuate locating the position of the corner:

- 1997: Placed 3" Alpena County cap stamped to identify the corner over 1/2" iron rod.
 Referenced:
 N85W - 35.90' - set tag in the corner post
 N63E - 78.13' - set tag in 6" scrub tree
 S43W - 50.87' - top of center of telephone box
 N85E - 83.22' - set tag in 4" scrub tree
 South 46.13' - Found pipe in intersection
 South 16.0' - Found bent rebar

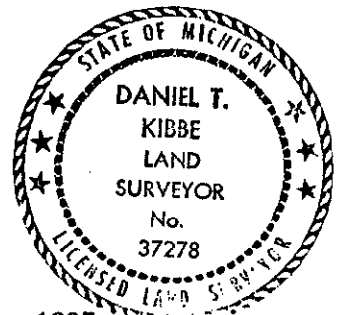

Signed by *Daniel T. Kibbe*
 Surveyor's Michigan License No. 37278

Date October 24, 1997