

1995 ALPENA COUNTY REMONUMENTATION CORNER

LAND CORNER RECORDATION CERTIFICATE
Filing Requirement of Act 74, Mich. P.A. 1970

JUN 16 2 53 PM '95

Myra A. Johnston
REGISTER OF DEEDS

corners in


<u>Alpena</u> (County)	Located In:	Corner Code #
Public Land Survey	T <u>29N</u> R <u>7E</u>	D-3 (N $\frac{1}{4}$, 8)
	T _____ R _____	Ossineke Twp.
	T _____ R _____	
	T _____ R _____	
Property Controlling in Section	S _____ T _____ R _____	
Miscellaneous	S _____ T _____ R _____	
Property in Sec.	S _____ T _____ R _____	

Register of Deeds Stamp & File Number

Lot No. _____, Recorded Plat _____
Private Claims _____

Thomas L. Fabis, in a field survey on March 23, 19 95,
I hereby certify that under requirements of P.A. 74, Michigan P.A. of 1970, the corner points mentioned in lines 1 and 2 above were in conformance with regulations and rules therefore as required in the current manual of survey instructions of the United States Department of the Interior, Bureau of Land Management or by a decree of a Court of Law and/or that the corner points mentioned in lines 3, 4 and 5 above were in conformance with the rules of the Michigan Board of Land Surveyors or by a Decree of a Court of Law; established, re-established, monumented, re-monumented, recovered, found as expressed below:

NOTE: Not more than 4 corners, all in the same town and range, may be recorded on this certificate.

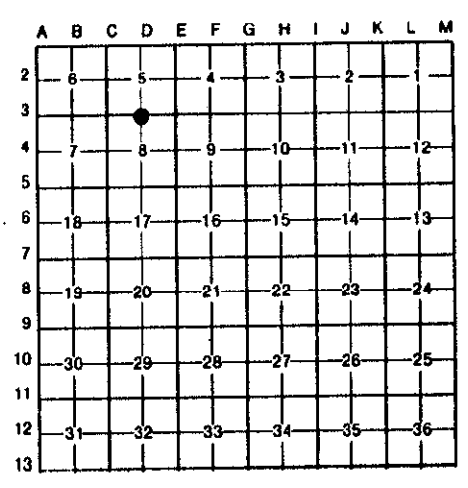

- A. Description of original monument and accessories and/or subsequent restoration:
1839: G.L.O. Survey by Lewis Clason - Set post & referenced: (Aspen 12 - S17E - 18, Tam 11 - N25W - 27).
1905: County Survey by Jos. W. McNeil - Set large cedar stake.

- B. Description of corner evidence found and/or method applied in restoring or reestablishing corner:
1995: Did Not find corner monument. Set $\frac{1}{2}$ " iron rod by single proportionate method on line and midway between the two opposite Section corners. Corner falls in the center of E-W gravel road with fence to the North.

The position of this corner is compatible with the early county surveys and is accepted as a careful and faithful reestablishment of the position of the original corner.


AUG 23 1995

COMMISSION

- C. Description of monument for corner and accessories established to perpetuate locating the position of the corner:
1995: Set $\frac{1}{2}$ " iron rod with 3" dia. aluminum cap, stamped to identify the corner.
Reestablished witnesses are:
Set tag #31591 in P. Pole - S38E - 44.52'
Set tag #31591 in Anchor Pole - N40E - 44.41'
Set tag #31591 in Co. Fe. Post - North - 31.73'
Set tag #31591 in 16" Cedar - S60E - 115.16'

P.A. 345 ALPENA COUNTY
PEER APPROVED May 18, 1995
Det. R. Lila

Signed by Thomas L. Fabis
Surveyor's Michigan License No. 31591

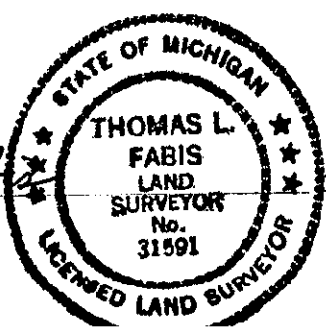

Date June 12, 1995