

SURVEY & REMONUMENTATION

FEB 03 1998

1997 Alpena County Remonumentation Corner

LAND CORNER RECORDATION CERTIFICATE

Filing Requirement of Act 74, Mich. P.A. 1970

SECTION

For corners in

Liber **00002** Page **0123**

STATE OF MICHIGAN
County of Alpena
Recorded
11-06-1997 15:32:18
Kathy J. Matash
REGISTER OF DEEDS

Register of Deeds Stamp & File Number

<u>Alpena</u> (County)	Located In:	Corner Code #
1. Public Land Survey	T <u>29</u> N R <u>7</u> E	<u>D-7</u>
	T <u> </u> R <u> </u>	<u> </u>
	T <u> </u> R <u> </u>	<u> </u>
	T <u> </u> R <u> </u>	<u> </u>
2. Property Controlling in Section	S <u> </u> T <u> </u> R <u> </u>	<u> </u>
	S <u> </u> T <u> </u> R <u> </u>	<u> </u>
3. Miscellaneous Property in Sec.	S <u> </u> T <u> </u> R <u> </u>	<u> </u>
	S <u> </u> T <u> </u> R <u> </u>	<u> </u>

4. Lot No. _____, Recorded Plat _____
5. Private Claims _____

I, Daniel T. Kibbe, in a field survey on March 27, 1997 do hereby state that under requirements of P.A. 74, Michigan P.A. of 1970, the corner points mentioned in lines 1 and 2 above were in conformance with regulations and rules therefore as required in the current manual of survey instructions of the United States Department of the Interior, Bureau of Land Management or by a decree of a Court of Law and for that the corner points mentioned in lines 3, 4 and 5 above were in conformance with the rules of the Michigan Board of Land Surveyors or by a Decree of a Court of Law; established, re-established, monumented, recovered, found as expressed below:

NOTE: Not more than 2 corners, all in the same town and range, may be recorded on this certificate.

P.A. 345 ALPENA COUNTY
PEER APPROVED 7/23/97
D. P. [Signature]

1	A	B	C	D	E	F	G	H	I	J	K	L	M
2		6		5		4		3		2		1	
3													
4		7		8		9		10		11		12	
5													
6		18		17		16		15		14		13	
7				●									
8		19		20		21		22		23		24	
9													
10		30		29		28		27		26		25	
11													
12		31		32		33		34		35		36	
13													


- A. Description of original monument and accessories and/or subsequent restoration:
- 1839: GLO survey by Lewis Clason - set $\frac{1}{4}$ post, referenced: Beech 9-N25E-20 / Beech 14-S67W-38
 - 1896: County survey by Fred A. Rice - old corner burned, set new corner, referenced: W. Pine St 36"-South-14 links
 - 1905: County survey - Fd. stake set by Rice
 - 1978: County Rd. Commission survey by Gary St. Charles - fd. T-Bar, referenced: N40E-76.00'-20" Pear Tree / S20E-59.25' - 18" Apple Tree
 - 1989: Survey by Duane R. MacNeill

B. Description of corner evidence found and/or method applied in restoring or reestablishing corner:
1997: Found $\frac{1}{2}$ " rebar in monument box in centerline E-W road on fence line to North.

This corner position is compatible with county & local surveys. This corner position is accepted as a careful and faithful perpetuation of the position of the original corner.

C. Description of monument for corner and accessories established to perpetuate locating the position of the corner:
1997: Placed 3" Alpena County cap stamped to identify the corner over $\frac{1}{2}$ " iron rod in monument box.

- Referenced:
- N61E - 75.97' - fd. nail overgrown in 23" pear tree, set tag above
 - S07E - 59.20' - set tag in 20" apple
 - S60W - 83.75' - NW corner of square fence post
 - N13W - 32.99' - set tag in P. Pole

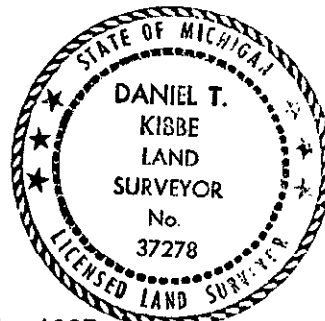

Signed by *Daniel T. Kibbe*
Surveyor's Michigan License No. 37278

Date October 24, 1997