

SURVEY & REMONUMENTATION

FEB 03 1998

1997 Alpena County Remonumentation Corner LAND CORNER RECORDATION CERTIFICATE Filing Requirement of Act 74, Mich. P.A. 1970

SECTION

For corners in

Alpena	Located In:	Corner Code #
(County)		
1. Public Land Survey	T29N R7E	E-7
	T___ R___	_____
	T___ R___	_____
	T___ R___	_____
2. Property Controlling in Section	S___ T___ R___	_____
	S___ T___ R___	_____
3. Miscellaneous Property in Sec.	S___ T___ R___	_____
	S___ T___ R___	_____

Liber **00002** Page **0124**
STATE OF MICHIGAN
County of Alpena
Recorded
11-06-1997 15:32:28
Kathy J. Matash
REGISTER OF DEEDS

Register of Deeds Stamp & File Number

4. Lot No. _____, Recorded Plat _____
5. Private Claims _____

I, Daniel T. Kibbe, in a field survey on March 27, 1997 do hereby state that under requirements of P.A. 74, Michigan P.A. of 1970, the corner points mentioned in lines 1 and 2 above were in conformance with regulations and rules therefore as required in the current manual of survey instructions of the United States Department of the Interior, Bureau of Land Management or by a decree of a Court of Law and /or that the corner points mentioned in lines 3, 4 and 5 above were in conformance with the rules of the Michigan Board of Land Surveyors or by a Decree of a Court of Law; established, re-established, monumented, recovered, found as expressed below:

NOTE: Not more than 2 corners, all in the same town and range, may be recorded on this certificate.

P.A. 345 ALPENA COUNTY
PEER APPROVED 7/23/97
Daniel T. Kibbe

	A	B	C	D	E	F	G	H	I	J	K	L	M
1													
2	6		5		4		3		2		1		
3													
4	7		8		9		10		11		12		
5													
6	18		17		16		15		14		13		
7					●								
8	19		20		21		22		23		24		
9													
10	30		29		28		27		26		25		
11													
12	31		32		33		34		35		36		
13													

- A. Description of original monument and accessories and/or subsequent restoration:**
- 1839: GLO survey by Lewis Clason - set post, referenced: Cedar 9-N21W-18 / Tam 20-S48E-40
 - 1896: County survey by Fred A. Rice - corner plainly marked
 - 1905 & 1914: O.B.T. stumps standing & stake in center of road bed flush with road, referenced: Cedar 8-N21W-18 / Rotted Tam 20-S48E-40, by Jos. W. McNeil
 - 1973: Land Corner Recordation by James L. Scott - 1/2" rod set from County Surveyors notes ex. corners since 1946 perpetuated by Scott Engineering Co., referenced: S40E-99.24' - 12" Maple / N25E - 67.6' - 12" Ash / N23W - 44.9' - T.P.
 - 1978: County Rd. Commission survey by Gary St. Charles - fd. 1/2" rerod, referenced: N60W - 45.9' - P. Pole

B. Description of corner evidence found and/or method applied in restoring or reestablishing corner:

- 1993: Survey by Earl T. Lewis - Found 1/2" rod N50E - 81.25' P. Pole / N80W 182.2' P. Pole / S30E - 86.55' 8" Aspen / North 21.5' sign post.


B.

- 1997: Found 1/2" rebar 5' North of centerline E-W road, in centerline road to South, on woods line to North.

This corner position is compatible with county & local surveys. This corner position is accepted as a careful and faithful perpetuation of the position of the original corner.

C. Description of monument for corner and accessories established to perpetuate locating the position of the corner:

- 1997: Placed 3" Alpena County cap stamped to identify the corner over 1/2" iron rod in monument box.
Referenced:
S37W - 62.88' - Found tag in Power Pole
S26W - 91.93' - Found tag in Power Pole
N73E - 81.10' - Set tag in Power Pole
N07E - 21.50' - Road sign post

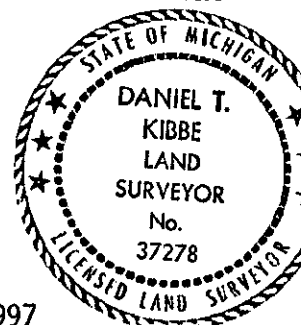

Signed by *Daniel T. Kibbe*
Surveyor's Michigan License No. 37278

Date October 24, 1997