

SURVEY & REMONUMENTATION

FEB 18 1999

1998 Alpena County Remonumentation

SECTION

LAND CORNER RECORDATION CERTIFICATE Liber 000002 Page 0177
Filing Requirement of Act 74, Mich. P.A. 1970

For corners in

Alpena

(County)

Located In:

Corner Code #

1. Public Land Survey

T 29NR 07E

G-5

T R

T R

T R

2. Property Controlling in Section

S T R

S T R

3. Miscellaneous Property in Sec.

S T R

S T R

STATE OF MICHIGAN
County of Alpena
Recorded
12-21-1998 12:36:38
Kathy J. Matak
REGISTER OF DEEDS

Register of Deeds Stamp & File Number

4. Lot No. , Recorded Plat

5. Private Claims

I, Wayne T. Lewis, in a field survey on 11-30, 19 98 do hereby state that under requirements of P.A. 74, Michigan P.A. of 1970, the corner points mentioned in lines 1 and 2 above were in conformance with regulations and rules therefore as required in the current manual of survey instructions of the United States Department of the Interior, Bureau of Land Management or by a decree of a Court of Law and/or that the corner points mentioned in lines 3, 4 and 5 above were in conformance with the rules of the Michigan Board of Land Surveyors or by a Decree of a Court of Law; established, re-established, monumented, recovered, found as expressed below:

NOTE: Not more than 2 corners, all in the same town and range, may be recorded on this certificate.

Grid table with columns A-L and rows 1-13. A dot is marked at the intersection of column G and row 5.

A. Description of original monument and accessories and/or subsequent restoration:

- 1835: LEWIS GLASON - SET POST AND WITNESSED
1892: WM. H. LEROY - RE-ESTABLISHED CORNER, SET CEDAR STAKE, 5" SQUARE
1904: J.W. MCNEIL - LARGE STAKE IN CENTER OF ROAD, NO WITNESSES
1910: J.W. MCNEIL - FOUND CORNER, NO WITNESSES
1973: JAMES L. SCOTT, P.S. - FOUND PIPE, AND RECORDED LCRC LIBER 1, PAGE 29, AND WITNESSED
1978: D. B. GUTHRIE, P.S. - FOUND MON. BOX, AND WITNESSED
1976: ALPENA COUNTY ROAD COMMISSION - WITNESSED CORNER, NO MONUMENTATION GIVEN
1993: E.T. LEWIS, P.S. - FOUND MON. BOX, AND WITNESSED
1994 AND 1995: E.T. LEWIS, P.S. - FOUND 5/8" REROD IN MON. BOX AND WITNESSED

3. Description of corner evidence found and/or method applied in restoring or reestablishing corner:

FOUND 1/2" REROD IN MON. BOX IN INTERSECTION OF HUBBARD LAKE ROAD AND KLEVE ROAD

THIS CORNER POSITION IS ACCEPTED AS A CAREFUL AND FAITHFUL PERPETUATION OF THE POSITION OF THE ORIGINAL CORNER.

P.A. 345 ALPENA COUNTY
PEER APPROVED 12/17/98


Handwritten signature

C. Description of monument for corner and accessories established to perpetuate locating the position of the corner:

1998: PLACED 3" ALPENA COUNTY CAP, STAMPED TO IDENTIFY THE CORNER, OVER EXISTING 1/2" REROD IN MONUMENT BOX

WITNESSED:

- S 45° W 54.22' FENCE CORNER (FD. NAIL ON BACKSIDE OF POST)
N 45° W 60.55' FENCE POST (FD. ROOFING NAIL)
S 50° E 54.43' POWER POLE (FD. PK NAIL)
N 35° E 129.30' 7" WHITE PINE

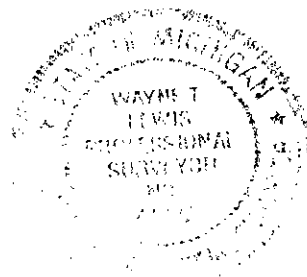

Signed by [Signature]
Surveyor's Michigan License No. 41922

Date December 18, 1998