

**SURVEY &  
REMONUMENTATION**

FEB 18 1999

1998 Alpena County Remonumentation

**LAND CORNER RECORDATION CERTIFICATE** Liber 000002 Page 0178  
Filing Requirement of Act 74, Mich. P.A. 1970

For corners in

Alpena

(County)

Located In:

Corner Code #

1. Public Land Survey

T29N R 07E

G-6

T \_\_\_ R \_\_\_

T \_\_\_ R \_\_\_

T \_\_\_ R \_\_\_

2. Property Controlling  
in Section

S \_\_\_ T \_\_\_ R \_\_\_

S \_\_\_ T \_\_\_ R \_\_\_

3. Miscellaneous  
Property in Sec.

S \_\_\_ T \_\_\_ R \_\_\_

S \_\_\_ T \_\_\_ R \_\_\_

STATE OF MICHIGAN  
County of Alpena  
Recorded  
12-21-1998 12:36:29  
Kathe J. Matak  
REGISTER OF DEEDS

Register of Deeds Stamp & File Number

4. Lot No. \_\_\_\_\_, Recorded Plat \_\_\_\_\_

5. Private Claims \_\_\_\_\_

I, Wayne T. Lewis, in a field survey on 11-30, 19 98 do hereby state that under requirements of P.A. 74, Michigan P.A. of 1970, the corner points mentioned in lines 1 and 2 above were in conformance with regulations and rules therefore as required in the current manual of survey instructions of the United States Department of the Interior, Bureau of Land Management or by a decree of a Court of Law and/or that the corner points mentioned in lines 3, 4 and 5 above were in conformance with the rules of the Michigan Board of Land Surveyors or by a Decree of a Court of Law; established, re-established, monumented, recovered, found as expressed below:

NOTE: Not more than 2 corners, all in the same town and range, may be recorded on this certificate.

	A	B	C	D	E	F	G	H	I	J	K	L	M
1													
2		6		5		4		3		2		1	
3													
4		7		8		9		10		11		12	
5													
6		18		17		16	●	15		14		13	
7													
8		19		20		21		22		23		24	
9													
10		30		29		28		27		26		25	
11													
12		31		32		33		34		35		36	
13													

A. Description of original monument and accessories and/or subsequent restoration:

- 1835: LEWIS GLASON - SET POST AND WITNESSED
- 1892: WM. H. LEROY - RE-ESTABLISHED CORNER, SET TAMARACK STAKE, 3" SQUARE
- 1904: J.W. MCNEIL - LARGE STAKE IN CENTER OF ROAD, NO WITNESSES
- 1975: R.H. PAQUETTE, P.S. AND D.B. GUTHRIE, P.S. - SET CORNER BY S.P. AND RECORDED CORNER IN LIBER 1 PAGE 73, AND WITNESSED
- 1976: ALPENA COUNTY ROAD COMMISSION - APPROXIMATE 1/4 CORNER, NO MONUMENTATION GIVEN, AND WITNESSED
- 1997: D.R. MACNEILL, P.S. - FOUND MON. BOX, NO WITNESSES GIVEN
- 1987: D.B. GUTHRIE, P.S. - FOUND CONCRETE MONUMENT, AND WITNESSED
- 1989 AND 1991: E.T. LEWIS, P.S. - FOUND MON. BOX AND WITNESSED
- 1993: E.T. LEWIS, P.S. - FOUND MON. BOX AND WITNESSED

B. Description of corner evidence found and/or method applied in restoring or reestablishing corner:

FOUND 1/2" REROD IN MON. BOX IN CENTERLINE OF HUBBARD LAKE ROAD, NO OCCUPATION EASTWEST

THIS CORNER POSITION IS ACCEPTED AS A CAREFUL AND FAITHFUL PERPETUATION OF THE POSITION OF THE ORIGINAL CORNER.

P.A. 345 ALPENA COUNTY  
PEER APPROVED 12/17/98


*D.D. B. Co*

C. Description of monument for corner and accessories established to perpetuate locating the position of the corner:

1998: PLACED 3" ALPENA COUNTY CAP, STAMPED TO IDENTIFY THE CORNER, OVER EXISTING 1/2" REROD IN MONUMENT BOX

WITNESSED:

- N 30° E 129.55' POWER POLE (FD TAG #22435)
- S 35° E 107.15' 15" SPRUCE (FD TAG #22435)
- S 75° E 70.15' 15" WILLOW (FD. TAG #27452)
- S 20° E 188.35' POWER POLE (FD ROOFING NAIL)

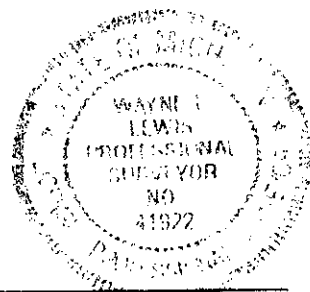

Signed by *Wayne T. Lewis*  
Surveyor's Michigan License No. 41922

Date December 18, 1998