

**2000 Alpena County Remonumentation Corner
LAND CORNER RECORDATION CERTIFICATE**
Filing Requirement of Act 74, Mich. P.A. 1970

For corners in


<u>Alpena</u> <small>(County)</small>	Located In:	Corner Code #
1. Public Land Survey	T <u>29N</u> R <u>7E</u>	<u>H-3</u>
	T <u> </u> R <u> </u>	<u> </u>
	T <u> </u> R <u> </u>	<u> </u>
	T <u> </u> R <u> </u>	<u> </u>
2. Property Controlling in Section	S <u> </u> T <u> </u> R <u> </u>	<u> </u>
	S <u> </u> T <u> </u> R <u> </u>	<u> </u>
3. Miscellaneous Property in Sec.	S <u> </u> T <u> </u> R <u> </u>	<u> </u>
	S <u> </u> T <u> </u> R <u> </u>	<u> </u>



L-2 P-326
08/16/2000 09:32A
Page: 1 of 1
Kathy J. Mataah, Register Alpena Co., MI LDC 9.00

Register of Deeds Stamp & File Number

4. Lot No. _____, Recorded Plat _____
5. Private Claims _____

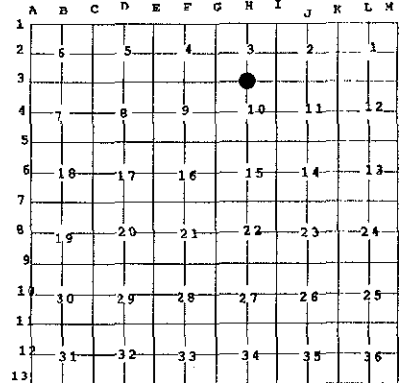

I, Daniel T. Kibbe, in a field survey on March 8, 2000 do hereby state that under requirements of P.A. 74, Michigan P.A. of 1970, the corner points mentioned in lines 1 and 2 above were in conformance with regulations and rules therefore as required in the current manual of survey instructions of the United States Department of the Interior, Bureau of Land Management or by a decree of a Court of Law and/or that the corner points mentioned in lines 3, 4 and 5 above were in conformance with the rules of the Michigan Board of Land Surveyors or by a Decree of a Court of Law; established, re-established, monumented, recovered, found as expressed below:

NOTE: Not more than 2 corners, all in the same town and range, may be recorded on this certificate.

A. Description of original monument and accessories and/or subsequent restoration:

- 1839: GLO Survey by Lewis Clawson Set quarter post.
Referenced: Hemlock 28-N37°E-38/Hemlock 16-S52° W-38
- 1904: County Survey by Jos. W. McNeil No old marks. Set corner in road bed
- 1977: Survey by Duane R. MacNeil Set 1" Pipe.
Referenced: 3" Balsam-N41°E-51.55'/Mailbox Post-N30°W-20.44'/ Fence Post-South-34.82'
- 1981: County Survey by Gary St. Charles Found 1/2" rebar
Referenced: Fence Post-South-54.26'/1/2" rebar-North-42.95'/Tel. Pole-N80°W-74.45'
- 1994: Survey by Earl T. Lewis Existing 1/2" rod raised with 1/2" rod.
Referenced: Power Pole-N70°W-74.25'/SW Cor. Of Garage-N10°E-107.55'/ Power Pole-N70°E-125.35'/Power Pole-S80°E-204.95'
- 1999: Survey by Wayne T. Lewis Existing 1/2" rered
Referenced: Power Pole-N70°W-74.25'/SW Cor. Of Garage-N10°E-107.55'/ Power Pole-N70°E-125.35'/Power Pole-S80°E-204.95'

B. Description of corner evidence found and/or method applied in restoring or reestablishing corner:

Found two 1/2" diameter rebar beside 1/2"x 3 1/2" wood stake. Used deepest (0.5') rebar tight to stake. Corner is in centerline E-W road on fence line South. 50' North of corner fence post (fence E+S). Found no evidence of 1977 D.R.M. pipe or witnesses.


This corner position is compatible with county & local surveys. This corner position is accepted as a careful and faithful perpetuation of the position of the original corner.

C. Description of monument for corner and accessories established to perpetuate locating the position of the corner:

- 2000: Placed 3" Alpena County cap stamped to identify the corner over 1/2" iron rod 6" below grade.
Referenced:
Found tag in power pole S75°E-204.67'
Found tag in power pole N60°W-74.31'
Found tag in power pole N70°E-125.13'
SW corner block garage N12°E-107.43'
Set nail and tag in power pole S80W-219.79'

P.A. 345 ALPENA COUNTY
PEER APPROVED 7-12-2000
D.D.B. T

Signed by *Daniel T. Kibbe*
Surveyor's Michigan License No. 37278

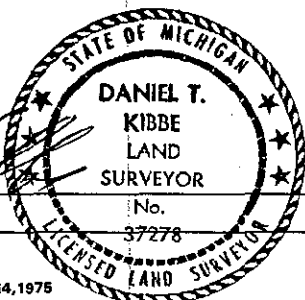

Date August 14, 2000

FORM APPROVED BY MICHIGAN STATE BOARD OF

PROFESSIONAL SURVEYORS, JAN. 28, 1971

REVISED MAY 14, 1975

REVISED JAN., 1983
REVISED OCT., 1995

**SURVEY &
REMONUMENTATION**

JAN 25 2001

SECTION