

**2000 Alpena County Remonumentation Corner
LAND CORNER RECORDATION CERTIFICATE**
Filing Requirement of Act 74, Mich. P.A. 1970

For corners in

<u>Alpena</u> <small>(County)</small>	Located In:	Corner Code #
1. Public Land Survey	T 29N R7E	H-9
	T R	
	T R	
	T R	
2. Property Controlling in Section	S T R	
	S T R	
3. Miscellaneous Property in Sec.	S T R	
	S T R	

L- 2 P- 329
08/16/2000 09:32A
Page: 1 of 1
Kathy J. Matash, Register Alpena Co., MI LDC 9.00

Register of Deeds Stamp & File Number

4. Lot No. _____, Recorded Plat _____
5. Private Claims _____

	A	B	C	D	E	F	G	H	I	J	K	L	M
1													
2	6		5		4		3		2		1		
3													
4	7		8		9		10		11		12		
5													
6	13		17		16		15		14		13		
7													
8	15		20		21		22		23		24		
9													
10	30		29		28		27		26		25		
11													
12	31		32		33		34		35		36		
13													

I, Daniel T. Kibbe, in a field survey on March 8, 2000 do hereby state that under requirements of P.A. 74, Michigan P.A. of 1970, the corner points mentioned in lines 1 and 2 above were in conformance with regulations and rules therefore as required in the current manual of survey instructions of the United States Department of the Interior, Bureau of Land Management or by a decree of a Court of Law and/or that the corner points mentioned in lines 3, 4 and 5 above were in conformance with the rules of the Michigan Board of Land Surveyors or by a Decree of a Court of Law; established, re-established, monumented, recovered, found as expressed below:

NOTE: Not more than 2 corners, all in the same town and range, may be recorded on this certificate.

A. Description of original monument and accessories and/or subsequent restoration:

- 1839: GLO Survey by Lewis Clawson Set quarter post.
Referenced: Sugar Maple 9-S71°E-18/Hamlock 15-N66°W-25
- 1904: County Survey by Jos. W. McNeil Found corner in old road. Did not find any obt., nearly everything burnt. Set large cedar stake.
Referenced: White Pine Stump 36- S20°W-42 ½
- 1909: County Survey by Jos. W. McNeil Found corner in road bed.
- 1985: Survey by Earl T. Lewis Existing ½" rod
Power Pole-S25°E 43.6'
26" Maple North 28.95'

B. Description of corner evidence found and/or method applied in restoring or reestablishing corner:

Found ½" rebar. 3' North of centerline. 0.8' deep on old fence line to North.


This corner position is compatible with county & local surveys. This corner position is accepted as a careful and faithful perpetuation of the position of the original corner.

C. Description of monument for corner and accessories established to perpetuate locating the position of the corner:

- 2000: Placed 3" Alpena County cap stamped to identify the corner over 1/2" iron rod 6" below grade.
Referenced:
Set tag in 10" jack pine-N58°W-35.96'
Found flagging set tag in 20" twin maple-N04°W-28.82'
Set tag in power pole-S19°E-38.75'
Set tag in 12" jack pine-S53°W-93.77'

P.A. 345 ALPENA COUNTY
PEER APPROVED 7-12-2000
D.T.B.

Signed by *Daniel T. Kibbe*
Surveyor's Michigan License No. 37278

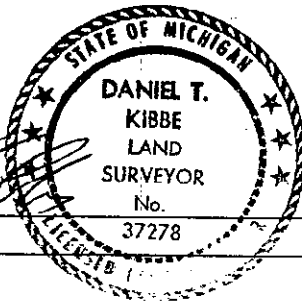

Date August 14, 2000

PROFESSIONAL SURVEYORS, JAN. 28, 1971

REVISED MAY 14, 1975

FORM APPROVED BY MICHIGAN STATE BOARD OF

REVISED JAN., 1983
REVISED OCT., 1995

**SURVEY &
REMONUMENTATION**

JAN 25 2001

SECTION