

**2000 Alpena County Remonumentation Corner  
LAND CORNER RECORDATION CERTIFICATE  
Filing Requirement of Act 74, Mich. P.A. 1970**

For corners in

<u>Alpena</u> <small>(County)</small>	Located In:	Corner Code #
1. Public Land Survey	T <u>29N</u> R <u>7E</u>	<u>1-3</u>
	T <u>    </u> R <u>    </u>	<u>    </u>
	T <u>    </u> R <u>    </u>	<u>    </u>
	T <u>    </u> R <u>    </u>	<u>    </u>
2. Property Controlling in Section	S <u>    </u> T <u>    </u> R <u>    </u>	<u>    </u>
	S <u>    </u> T <u>    </u> R <u>    </u>	<u>    </u>
3. Miscellaneous Property in Sec.	S <u>    </u> T <u>    </u> R <u>    </u>	<u>    </u>
	S <u>    </u> T <u>    </u> R <u>    </u>	<u>    </u>




**L- 2 P- 327**  
08/16/2000 09:32A  
Page: 1 of 1

Kathy J. Matash, Register Alpena Co., MI LDC 9.00  
Register of Deeds Stamp & File Number

4. Lot No. \_\_\_\_\_, Recorded Plat \_\_\_\_\_  
5. Private Claims \_\_\_\_\_

I, Daniel T. Kibbe, in a field survey on March 8, 2000 do hereby state that under requirements of P.A. 74, Michigan P.A. of 1970, the corner points mentioned in lines 1 and 2 above were in conformance with regulations and rules therefore as required in the current manual of survey instructions of the United States Department of the Interior, Bureau of Land Management or by a decree of a Court of Law and /or that the corner points mentioned in lines 3, 4 and 5 above were in conformance with the rules of the Michigan Board of Land Surveyors or by a Decree of a Court of Law; established, re-established, monumented, recovered, found as expressed below:

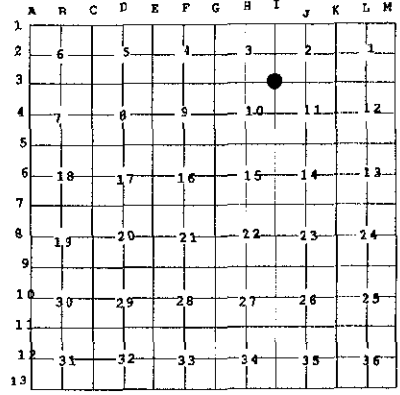

**NOTE: Not more than 2 corners, all in the same town and range, may be recorded on this certificate.**

**A. Description of original monument and accessories and/or subsequent restoration:**

- 1839: GLO Survey by Lewis Clawson Set corner post. Referenced: Aspen 9-S24°W-49/ Aspen 8-N21°E-22
- 1905: County Survey by Jos. W. McNeil Cedar stake in center of roadbed previously set from obt's
- 1915: County Survey by Jos. W. McNeil Found corner in center of crossroads. Set large new stake in place of old one flush with roadbed. Government distance for this mile 79.92chains, 40.00 and 39.92
- 1977: Survey by David B. Guthrie Existing 1/2" iron rod Referenced: Power Pole-N45°E-58.46'/ Power Pole-N45°W-48.55'/ Power Pole-S45°E-46.30'
- 1981: County Survey by Gary St. Charles Existing 1/2" rebar Referenced: Tel. Pole-N45°E-58.61'/Power Pole-S35°E-46.50'/Tel. Pole-N45°W-48.48'
- 1994: Survey by Earl T. Lewis Existing 1/2" rod raised with 1/2" rod. Referenced: Power Pole-N45°E-46.65'/Stop Sign-S10°E-65.8'/Def. Marker-N45°W-48.0'/ 6" Apple-S15°W-98.35'
- 1996: Survey by Wayne T. Lewis Existing 1/2" rod. Referenced: Power Pole-N45°E-46.65'/Stop Sign-S10°E-65.80'/Tel. Marker-N45°W-48.00'/ 6" Apple-S15°W-98.35'

**B. Description of corner evidence found and/or method applied in restoring or reestablishing corner:**

Found 1/2" rebar flush, bent 1' South of Centerline E & W road. 2' East of centerline N & S road. Continued excavation and found another 1/2" rebar, .6' below surface.


This corner position is compatible with county & local surveys. This corner position is accepted as a careful and faithful perpetuation of the position of the original corner.

**C. Description of monument for corner and accessories established to perpetuate locating the position of the corner:**

- 2000: Placed 3" Alpena County cap stamped to identify the corner over 1/2" iron rod 6" below grade. Referenced: Found P.K. & flagging, set tag over in power pole-S35°E-46.66' Found spike in 9" apple-S36°W-98.33 Top center of telephone riser-N36°W-47.94 Face of stop sign post-S03°E-66.00

P.A. 345 ALPENA COUNTY  
PEER APPROVED 7-12-2000  
D.T.B.E

Signed by Daniel T. Kibbe  
Surveyor's Michigan License No. 37278

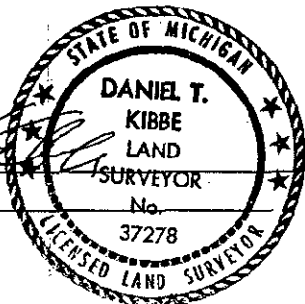

Date August 14, 2000

**SURVEY &  
REMONUMENTATION**  
  
**JAN 25 2001**  
  
**SECTION**