

FEB 18 1999

SECTION

1998 ALPENA COUNTY REMONUMENTATION CORNER

LAND CORNER RECORDATION CERTIFICATE
Filing Requirement of Act 74, Mich. P.A. 1970

00002 Page 0182

For corners in

<u>Alpena</u> (County)	Located in:	Corner Code #
1. Public Land Survey	T <u>29</u> N R <u>7</u> E	<u>I-11</u> ✓ <u>Ossineke Twp.</u>
	T ___ R ___	_____
	T ___ R ___	_____
	T ___ R ___	_____
2. Property Controlling in Section	S ___ T ___ R ___	_____
	S ___ T ___ R ___	_____
3. Miscellaneous Property in Sec.	S ___ T ___ R ___	_____
	S ___ T ___ R ___	_____

STATE OF MICHIGAN
County of Alpena
Recorded
12-22-1998 12:44:07
Kathy J. Mstaak
REGISTER OF DEEDS

Register of Deeds Stamp & File Number

4. Lot No. _____, Recorded Plat _____
5. Private Claims _____

I, Thomas L. Fabis, in a field survey on Dec. 4, 19 98 do hereby state that under requirements of P.A. 74, Michigan P.A. of 1970, the corner points mentioned in lines 1 and 2 above were in conformance with regulations and rules therefore as required in the current manual of survey instructions of the United States Department of the Interior, Bureau of Land Management or by a decree of a Court of Law and/or that the corner points mentioned in lines 3, 4 and 5 above were in conformance with the rules of the Michigan Board of Land Surveyors or by a Decree of a Court of Law; established, re-established, monumented, recovered, found as expressed below:

NOTE: Not more than 2 corners, all in the same town and range, may be recorded on this certificate.

	A	B	C	D	E	F	G	H	I	J	K	L	M
1													
2	6		5		4		3		2		1		
3													
4	7		8		9		10		11		12		
5													
6	18		17		16		15		14		13		
7													
8	19		20		21		22		23		24		
9													
10	30		29		28		27		26		25		
11													
12	31		32		33		34		35		36		
13													

A. Description of original monument and accessories and/or subsequent restoration:

- 1839: G.L.O. Survey Lewis Clason Set post Corner Sec. 26, 27, 34 & 35 & referenced: Y. Pine 26 S42W 56, W. Pine 16 N62E 04.
- 1909: County Survey Jos. McNeil Set long shaped stone in road for corner & pieces of an old stove around same and referenced.
- 1961: R.S.Scott Engineer. Co. Rd. Survey W.O. 4-2097 James Scott Fnd. rnd. stone with stove iron placed around it - replaced with 1"x24" pipe & referenced.
- 1974: Scott Engineering Survey W.O.4-4974 Fnd. RR and referenced.
- 1997: Survey Notes Wilcox/Hendricks 1/2" pipe E. edge of Rd. (N&S) in centerline of Rd. (E&W).

B. Description of corner evidence found and/or method applied in restoring or reestablishing corner:

- 1998: Found 3/4" Pipe in centerline of Scott Rd. (E-W gravel surface) 6 feet East of centerline of Osborn Rd. (N-S gravel surface). Found no existing witnesses.

The position of this corner is compatible with county and local surveys and is accepted as a careful and faithful perpetuation of the position of the original corner.


C. Description of monument for corner and accessories established to perpetuate locating the position of the corner:

- 1998: Replaced existing pipe with 1/2" iron rod with 3" dia. aluminum cap, stamped to identify the corner.
Reestablished witnesses are:
Road Sign S55W 42.61'
Stop Sign S15E 47.21'
Set Tag #31591 in 4" Aspen S40W 46.34'
Set Tag #31591 in P. Pole N35E 45.06'

P.A. 345 ALPENA COUNTY
PEER APPROVED 12/17/98
D.P. [Signature]

Signed by Thomas L. Fabis

Surveyor's Michigan License No. 31591

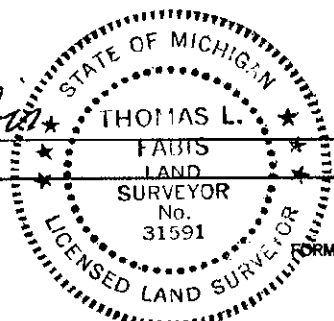

Date December 21, 1998