

SURVEY & REMONUMENTATION

NOV 16 1998

P.A. 345 ALPENA COUNTY

PEER APPROVED 8/14/98
Dad B. Kibbe

1998 Alpena County Remonumentation Corner
LAND CORNER RECORDATION CERTIFICATE
Filing Requirement of Act 74, Mich. P.A. 1970

Liber 00002 Page 0149

For corners in

<u>Alpena</u> (County)	Located In:	Corner Code #
1. Public Land Survey	T <u>29N</u> R <u>7E</u>	<u>J-7</u> ✓
	T _____ R _____	_____
	T _____ R _____	_____
	T _____ R _____	_____
2. Property Controlling in Section	S _____ T _____ R _____	_____
	S _____ T _____ R _____	_____
3. Miscellaneous Property in Sec.	S _____ T _____ R _____	_____
	S _____ T _____ R _____	_____

STATE OF MICHIGAN
County of Alpena
Recorded
08-20-1998 09:18:57
Kathy J. Matash
REGISTER OF DEEDS

Register of Deeds Stamp & File Number

4. Lot No. _____, Recorded Plat _____
5. Private Claims _____

I, Daniel T. Kibbe, in a field survey on February 24, 1998 do hereby state that under requirements of P.A. 74, Michigan P.A. of 1970, the corner points mentioned in lines 1 and 2 above were in conformance with regulations and rules therefore as required in the current manual of survey instructions of the United States Department of the Interior, Bureau of Land Management or by a decree of a Court of Law and/or that the corner points mentioned in lines 3, 4 and 5 above were in conformance with the rules of the Michigan Board of Land Surveyors or by a Decree of a Court of Law; established, re-established, monumented, recovered, found as expressed below:

NOTE: Not more than 2 corners, all in the same town and range, may be recorded on this certificate.

A	B	C	D	E	F	G	H	I	J	K	L	M
1												
2	6		5		4		3		2		1	
3												
4	7		8		9		10		11		12	
5												
6	18		17		16		15		14		13	
7												
8	19		20		21		22		23		24	
9												
10	30		29		28		27		26		25	
11												
12	31		32		33		34		35		36	
13												

A. Description of original monument and accessories and/or subsequent restoration:


- 1839: GLO Survey by Lewis Clason-set 1/4 section post; referenced: Aspen 7-N53E-7/Y.Pine 7-S35W-30
- 1904: County Survey by Jos. W. McNeil-ran from stake set by Gannon
- 1911: County Survey by Jos. W. McNeil-ran to Corner
- 1965: Road plans by James L. Scott-18" T iron; referenced: Corner fence post-North-32.90'/Corner fence post-South-33.20' Corner fence post-N45W-65.15'
- 1973: Survey by David B. Guthrie-found existing iron; referenced: Fence Corner-North-51.4'/Fence Post-S45W-68.6' Fence Post-N45E-65.4'
- 1977: Survey by David B. Guthrie-existing 3/4" rebar; referenced: Fence Corner-North-51.40'/Fence Post-S45W-68.60' Fence Post-N45E-65.40'
- 1981: Survey by David B. Guthrie-found existing iron; referenced: Fence Corner-North-51.4'/Fence Post-S45W-68.6' Fence Post-N45E-65.4'
- 1984: Survey by David B. Guthrie-existing 1/2" iron bar; referenced: Fence Corner-North-51.40'/Fence Post-S45W-68.60' Fence Post-N45E-65.40'
- 1996: Survey and Survey notes by Thomas L. Fabis-existing 5/8" iron rod; referenced: P.Pole-N18W-55.05'/Corner fence post-South-50.84'/Fence post-S20E-59.00'/Iron rod-North-50.08'

B. Description of corner evidence found and/or method applied in restoring or reestablishing corner:

- 1998: Remon Survey by Daniel T. Kibbe-found 5/8" rebar 0.5' N of centerline of E-W road. Old fence line to N & S
This corner position is compatible with county & local surveys. This corner position is accepted as a careful and faithful perpetuation of the position of the original corner.

C. Description of monument for corner and accessories established to perpetuate locating the position of the corner!

- 1998: Placed 3" Alpena County cap stamped to identify the corner over 1/2" iron rod in monument box.
Referenced:
Found Fabis tag in corner post-S04W-50.88'
Set tag in post-S44E-80.05'
Found Fabis tag in P.Pole-N22W-55.04'
Edge of metal post of cable sign-North-50.55'

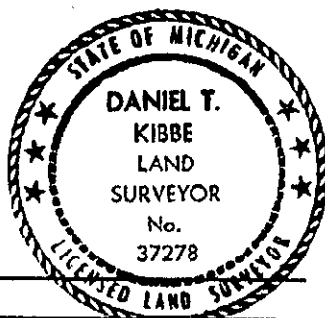

Signed by Daniel T. Kibbe
Surveyor's Michigan License No. 37278

Date August 14, 1998