

SURVEY & REMONUMENTATION

OCT 19 1999

1998 ALPENA COUNTY REMONUMENTATION CORNER

LAND CORNER RECORDATION CERTIFICATE
 Filing Requirement of Act 74, Mich. P.A. 1970

Number **000002** Page **0179**

SECTION

For corners in

Alpena <small>(County)</small>	Located in:	Corner Code #
1. Public Land Survey	T <u>29NR</u> 7E	J-11
	T ___ R ___	<u>Ossineke Twp.</u>
	T ___ R ___	_____
	T ___ R ___	_____
2. Property Controlling in Section	S ___ T ___ R ___	_____
3. Miscellaneous Property in Sec.	S ___ T ___ R ___	_____
	S ___ T ___ R ___	_____

STATE OF MICHIGAN
 County of Alpena
 Recorded
 12-22-1998 12:43:43
 Katho J. Maback
 REGISTER OF DEEDS

Register of Deeds Stamp & File Number

4. Lot No. _____, Recorded Plat _____
 5. Private Claims _____

	A	B	C	D	E	F	G	H	I	J	K	L	M
1													
2		6		5		4		3		2		1	
3													
4		7		8		9		10		11		12	
5													
6		18		17		16		15		14		13	
7													
8		19		20		21		22		23		24	
9													
10		30		29		28		27		26		25	
11										●			
12		31		32		33		34		35		36	
13													

I, Thomas L. Fabis, in a field survey on Dec. 4, 1998 do hereby state that under requirements of P.A. 74, Michigan P.A. of 1970, the corner points mentioned in lines 1 and 2 above were in conformance with regulations and rules therefore as required in the current manual of survey instructions of the United States Department of the Interior, Bureau of Land Management or by a decree of a Court of Law and /or that the corner points mentioned in lines 3, 4 and 5 above were in conformance with the rules of the Michigan Board of Land Surveyors or by a Decree of a Court of Law, established, re-established, monumented, recovered, found as expressed below:

NOTE: Not more than 2 corners, all in the same town and range, may be recorded on this certificate.

A. Description of original monument and accessories and/or subsequent restoration:

- 1839: G.L.O. Survey Lewis Clason Set 1/4 Section post & referenced: W. Pine 24 N45E 37, S. Maple 8 S38W 18.
- 1996: R.S.Scott Associates Mortgage Loan Inspection W.O.4-9580 David Guthrie Found 1 1/2" Iron Pipe.
- 1996: Lewis & Lewis Survey W.O. 0402965S Wayne Lewis Exis. Pipe & referenced.

P.A. 345 ALPENA COUNTY
 PEER APPROVED 12/17/98
J.D.R. Carr

B. Description of corner evidence found and/or method applied in restoring or reestablishing corner:


1998: Found 1 1/2" Pipe in centerline of Scott Rd. (gravel surface), 6 feet West of N-S fence to the North. This corner is in the S.P. position. Also found Lewis Tags in the following witnesses: P. Pole N10E 31.43', 8" Maple S10E 29.80' and Anchor Pole S45W 41.91'.

The position of this corner is compatible with local surveys and is accepted as a careful and faithful perpetuation of the position of the original.

C. Description of monument for corner and accessories established to perpetuate locating the position of the corner:

1998: Replaced existing 1 1/2" Pipe with a 1/2" iron rod with a 3" dia. alum. cap, stamped to identify the corner. Witnesses are:
 Set tag #31591 in 7" W. Pine S60W 63.72'
 Ex. Lewis Tag in Anchor Pole S45W 41.91'
 Ex. Lewis Tag in 8" Maple S10E 29.80'
 Ex. Lewis Tag in P. Pole N10E 31.43'

Signed by Thomas L. Fabis
 Surveyor's Michigan License No. 31591

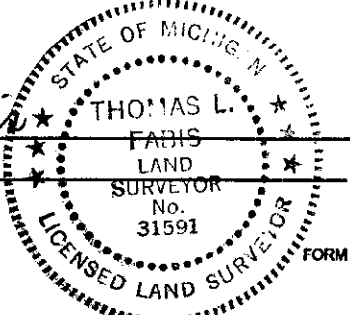

Date December 21, 1998