


**2000 Alpena County Remonumentation Corner
LAND CORNER RECORDATION CERTIFICATE**
Filing Requirement of Act 74, Mich. P.A. 1970

For corners in

<u>Alpena</u> <small>(County)</small>	Located In:	Corner Code #
1. Public Land Survey	T 29N R7E	K-2
	T _____ R _____	
	T _____ R _____	
	T _____ R _____	
2. Property Controlling in Section	S _____ T _____ R _____	 Kathy J. Matash, Register Alpena Co., MI LDC 9.00
3. Miscellaneous Property in Sec.	S _____ T _____ R _____	
	S _____ T _____ R _____	
	S _____ T _____ R _____	
	S _____ T _____ R _____	

L-2 P-319
08/18/2000 09:32A
Page: 1 of 1

Register of Deeds Stamp & File Number

4. Lot No. _____, Recorded Plat _____
5. Private Claims _____

	A	B	C	D	E	F	G	H	I	J	K	L	M
1													
2	6	5	4	3	2	1							
3													
4	7	8	9	10	11	12							
5													
6	18	17	16	15	14	13							
7													
8	15	20	21	22	23	24							
9													
10	30	29	28	27	26	25							
11													
12	31	32	33	34	35	36							
13													

I, Daniel T. Kibbe, in a field survey on March 8, 2000 do hereby state that under requirements of P.A. 74, Michigan P.A. of 1970, the corner points mentioned in lines 1 and 2 above were in conformance with regulations and rules therefore as required in the current manual of survey instructions of the United States Department of the Interior, Bureau of Land Management or by a decree of a Court of Law and /or that the corner points mentioned in lines 3, 4 and 5 above were in conformance with the rules of the Michigan Board of Land Surveyors or by a Decree of a Court of Law; established, re-established, monumented, recovered, found as expressed below:

NOTE: Not more than 2 corners, all in the same town and range, may be recorded on this certificate.

A. Description of original monument and accessories and/or subsequent restoration:

- 1839: GLO Survey by Lewis Clawson Set quarter post. Referenced: Cedar 12-N38°E-23/ Hemlock 24-S54°W-33
- 1892: County Survey by Wm. H. LeRoy Reestablished old quarter section, Cedar stake 4" sq. Referenced: Cedar 14-N39°E-23-obt/Hemlock 24-SW-down-obt Cedar 14-S70.5°E-43-nwt/Hemlock 22-N70.5°W-59-nwt
- 1904: County Survey by Jos. W. McNeil Ran to quarter section 1 and 2 in road
- 1928: County Survey by Wm. H. LeRoy Set well screen point 2' long for quarter corner in place of the old quarter corner I found in 1892 (See page 13 for survey of 1892)
- 1971: Survey by James L. Scott Existing Pipe Referenced: Fence Post-West-33.7'/ Fence Post-East-32.0'
- 1996: Survey by Earl T. Lewis Existing 5/8" rerod Referenced: Power Pole-East-31.24'/6" Jack Pine-N80°W-39.43'/4" Red Pine-N65°W-57.73' GTE Marker Post-West-31.68'

B. Description of corner evidence found and/or method applied in restoring or reestablishing corner:

Found 1/2" rebar in centerline of N & S road and centerline of E & W fence. Rebar is in well point.

This corner position is compatible with county & local surveys. This corner position is accepted as a careful and faithful perpetuation of the position of the original corner.


C. Description of monument for corner and accessories established to perpetuate locating the position of the corner:

2000: Placed 3" Alpena County cap stamped to identify the corner over 1/2" iron rod 6" below grade.
Referenced:

- Found. tag #27452 in power pole-S82°E-31.29'
- Found. tag #27452 in 7" red pine-N52°W-57.71'
- Found. tag #27452 in 8" jack pine-N78°W-39.45'
- Set tag in apple tree cluster-S40°W-69.23'

P.A. 345 ALPENA COUNTY
PEER APPROVED 7-12-2000
D.D.B. to

Signed by *Daniel T. Kibbe*
Surveyor's Michigan License No. 37278

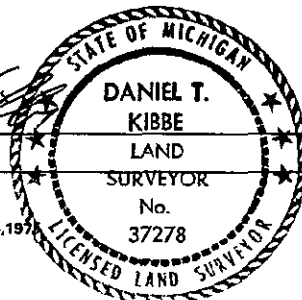

Date August 14, 2000

PROFESSIONAL SURVEYORS, JAN. 28, 1971

REVISED MAY 14, 1977

FORM APPROVED BY MICHIGAN STATE BOARD OF

REVISED JAN., 1983
REVISED OCT., 1998

**SURVEY &
REMONUMENTATION**

JAN 25 2001

SECTION