

**2000 Alpena County Remonumentation Corner
LAND CORNER RECORDATION CERTIFICATE**
Filing Requirement of Act 74, Mich. P.A. 1970

For corners in

<u>Alpena</u> <small>(County)</small>	Located In:	Corner Code #
1. Public Land Survey	T 29N R7E	K-3
	T _____ R _____	
	T _____ R _____	
	T _____ R _____	
2. Property Controlling in Section	S _____ T _____ R _____	
	S _____ T _____ R _____	
3. Miscellaneous Property in Sec.	S _____ T _____ R _____	
	S _____ T _____ R _____	




L- 2 P- 320
08/16/2000 09:32A
Page: 1 of 1

Kathy J. Matash, Register Alpena Co., MI LDC 9.00

Register of Deeds Stamp & File Number

4. Lot No. _____, Recorded Plat _____
5. Private Claims _____

I, Daniel T. Kibbe, in a field survey on March 8, 2000 do hereby state that under requirements of P.A. 74, Michigan P.A. of 1970, the corner points mentioned in lines 1 and 2 above were in conformance with regulations and rules therefore as required in the current manual of survey instructions of the United States Department of the Interior, Bureau of Land Management or by a decree of a Court of Law and /or that the corner points mentioned in lines 3, 4 and 5 above were in conformance with the rules of the Michigan Board of Land Surveyors or by a Decree of a Court of Law; established, re-established, monumented, recovered, found as expressed below:

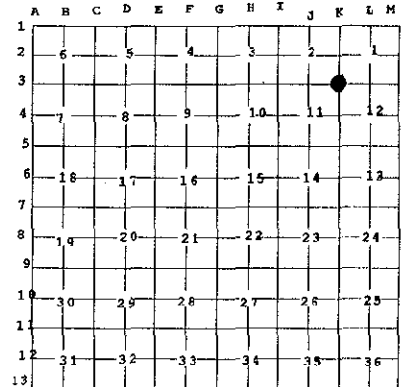

NOTE: Not more than 2 corners, all in the same town and range, may be recorded on this certificate.

A. Description of original monument and accessories and/or subsequent restoration:

- 1839: GLO Survey by Lewis Clawson Set Corner post. Referenced: Beech 14-N37°E-45'/ Hemlock 28-S60°W-46'
- 1892: County Survey by Wm. H. LeRoy Reestablished old corner. Set Hemlock stake 2" sq. Referenced: Down Beech 14-N37°E-45-obt/ Hemlock 28-S60°W-46-obt/ W. Pine Stump 48-S38.24°E-76 1/2-nwt/Beech 14-N73°W-56 1/2-nwt
- 1904: County Survey by McNeil Pulled old stake out of road bed and set new Jos. W. McNeil one in place of McNeil same. Made nwt. Referenced: Hemlock Stump 36-S32°W-76 1/2'
- 1928: County Survey by Wm. H. LeRoy Replaced old corner found in 1892 with 3/4" galvanized pipe 4' long. Placed small stones around pipe and one large blue boulder on east side of pipe (See page 13 for survey of 1892)
- 1971: Survey by James L. Scott Referenced Corner
- 1975: Survey by Duane R. MacNeil Found 1 1/2" Bolt. Referenced: Power Pole-S45°E-43.45'/ Power Pole-S45°W-40.76'/ Power Pole-N45°W-57.22'
- 1988: Survey by Earl T. Lewis Existing pipe. Referenced: Power Pole-S45°E-43.4'/16" Maple-S45°W-67.1'
- 1990: Survey by Earl T. Lewis Existing 1/2" Rod Referenced: 10" Cedar-West-40'/12" Cedar-N45°W-51.1'
- County Survey by Gary St. Charles Existing 1/2" rerod Referenced: 14" Cedar-N45°W-50.95'/6" Balsam-S30°E-105.97'/12" Cedar-S49°W-53.03'
- 1992: Survey by Thomas L. Fabis Existing Boat Spike Referenced: Power Pole-N48°W-59.78'/7" Maple-S46°W-89.42'/ Power Pole-S44°E-43.45'/
- 1993: Recorded Corner by Thomas Fabis Found Boat Spike. Referenced: Power Pole-N48°W-59.78'/7" Maple-S46°W-89.42'/ Power Pole-S44°E-43.45'/12" Apple-N28°E-92.75'
- 1996: Survey by Wayne Lewis Existing 5/8" rerod. Referenced: Found tag in Power Pole-N50°W-59.85'/ Found tag in Power Pole-S45°E-43.42'/ Found tag in 12" Apple-N25°E-92.98'/ Set tag in Power Pole-S50°W-54.95'

B. Description of corner evidence found and/or method applied in restoring or reestablishing corner:

Found boat spike, pulled and excavated 1 3/8" pipe, bent and pinched. Pulled and continued to excavate, found 3/4" straight galv. Pipe 1.9' below grade with plow point.

This corner position is compatible with county & local surveys. This corner position is accepted as a careful and faithful perpetuation of the position of the original corner.


C. Description of monument for corner and accessories established to perpetuate locating the position of the corner:

2000: Placed 3" Alpena County cap stamped to identify the corner over 1/2" iron rod 6" below grade.

Referenced:

- Found tag #27452 in power pole-S62°W-54.92'
- Found tag #31591 in power pole-N40°W-60.00'
- Found tag #31591 in 18" apple-N35°E-92.82'
- Found tag in power pole-S40°E-43.30'

Signed by [Signature]
Surveyor's Michigan License No. 37278

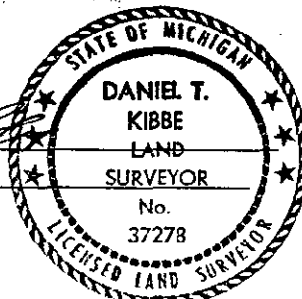

P.A. 345 ALPENA COUNTY
PEER APPROVED 7-12-00
[Signature]

Date August 14, 2000

PROFESSIONAL SURVEYORS, JAN. 28, 1971

REVISED MAY 14, 1975

FORM APPROVED BY MICHIGAN STATE BOARD OF

REVISED JAN., 1983
REVISED OCT., 1995

**SURVEY &
REMONUMENTATION**

JAN 25 2001

SECTION