

**2000 Alpena County Remonumentation Corner
LAND CORNER RECORDATION CERTIFICATE**
Filing Requirement of Act 74, Mich. P.A. 1970

For corners in

<u>Alpena</u> <small>(County)</small>	Located In:	Corner Code #
1. Public Land Survey	T 29N R7E	K-5
	T _____ R _____	
	T _____ R _____	
	T _____ R _____	
2. Property Controlling in Section	S _____ T _____ R _____	
	S _____ T _____ R _____	
3. Miscellaneous Property in Sec.	S _____ T _____ R _____	
	S _____ T _____ R _____	




L-2 P-322
08/16/2000 09:32A
Page: 1 of 1
Kathy J. Matash, Register Alpena Co., MI LDC 9.00

Register of Deeds Stamp & File Number

4. Lot No. _____, Recorded Plat _____
5. Private Claims _____

I, Daniel T. Kibbe, in a field survey on March 8, 2000 do hereby state that under requirements of P.A. 74, Michigan P.A. of 1970, the corner points mentioned in lines 1 and 2 above were in conformance with regulations and rules therefore as required in the current manual of survey instructions of the United States Department of the Interior, Bureau of Land Management or by a decree of a Court of Law and /or that the corner points mentioned in lines 3, 4 and 5 above were in conformance with the rules of the Michigan Board of Land Surveyors or by a Decree of a Court of Law; established, re-established, monumented, recovered, found as expressed below:

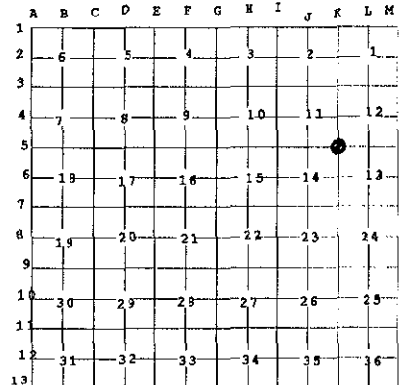

NOTE: Not more than 2 corners, all in the same town and range, may be recorded on this certificate.

A. Description of original monument and accessories and/or subsequent restoration:

- 1839: GLO Survey by Lewis Clawson Set corner post. Referenced: Cedar 14-N56°E-21'/Fir 8-S39 ½°W-22
- 1904: County Survey by Jos. W. McNeil Found corner and one obt down Cedar 14-N56°E-21'/Set new cedar stake and made nwt/Green Yellow Birch 13-N47°E-62
- 1909: County Survey by Jos. W. McNeil Found corner in N/S road. Large stake in corduroy and one NWT plain
- 1977: Survey by David B. Guthrie Existing 4" spike, replaced with ½" iron rod. Referenced: 8" Cedar-N45°W-44.50'/6" Cedar-West-38.44'/14" Maple-S45°W-46.32'
- 1990: Survey by Earl T. Lewis Existing ½" rod Referenced: 10" Cedar-West-40'/12" Cedar-N45°W-51.1'
- 1992: Survey by Duane R. MacNeill Found rerod
- 1993: Recorded Corner By Thomas L. Fabis Found Axle shaft. Set ½" iron rod P.S. # 31591 over existing axle shaft Referenced: 10" Cedar-S35°W-61.54'/7" Cedar-S85°W-45.51'/12" Cedar-N56°W-50.90' Anchor Pole-N72°E-62.15'
- County Survey by Gary St. Charles Found ½" rerod Referenced: 14" Cedar-N45°W-50.95'/6" Balsam-S30°E-105.97'/12" Cedar-S49°W-53.03 8" Cedar-N81°W-39.90'

B. Description of corner evidence found and/or method applied in restoring or reestablishing corner:

Found ½" rebar 0.6' below surface. Centerline of N/S road, 1' South of road to East. Removed rebar and found nothing beneath. Also found Fabis B+C LCRC Liber 1 page 244 this corner is 8.60' N40°E from above rebar and is 6' North and 6' East of centerline roads. Upon excavation beneath Fabis B+C 1.5' below grade found 1"x2" oval shaped shaft.


This corner position is compatible with county & local surveys. This corner position is accepted as a careful and faithful perpetuation of the position of the original corner.

C. Description of monument for corner and accessories established to perpetuate locating the position of the corner:

- 2000: Placed 3" Alpena County cap stamped to identify the corner over 1/2" iron rod 6" below grade. Raised with ½" rebar and referenced:
 Found WTL tag in 14" cedar S48°W 61.56'
 Found tag in 9" balsam S62°E 107.44'
 Found Fabis tag in anchor pole N77°E 62.26'
 Found WTL tag in 8" ash N60°W 34.72'
 Set nail and tag over over-grown nail in 14" cedar N51°W44.61'
 Found ½" rebar S40°W 8.60'

P.A. 345 ALPENA COUNTY
PEER APPROVED 7-12-2000
D.B.W.

Signed by Daniel T. Kibbe
Surveyor's Michigan License No. 37278

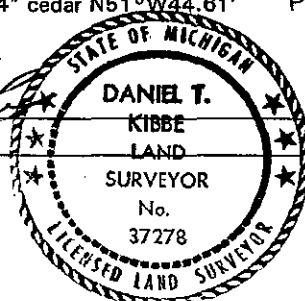

Date August 14, 2000

PROFESSIONAL SURVEYORS, JAN. 28, 1971

REVISED MAY 14, 1975

FORM APPROVED BY MICHIGAN STATE BOARD OF

REVISED JAN., 1983
REVISED OCT., 1995

**SURVEY &
REMONUMENTATION**

JAN 25 2001

SECTION